

LATITUDE 39 35



35S
88W

LONGITUDE 80 10

7'5 OGIS topo location

7.5' loc _____
_____ 15' loc
_____ (calc.) _____

Company _____

Farm DANIEL HIBBS 5050

Quad GRANT TOWN

County MARION


District Paw Paw

WELL LOCATION MAP

File No. 30015

1730
TO BE ABANDONED

W.VA. GAS COMPANY OF PITTSBURGH PA
LEASE NO. 13044 LESSOR DANIEL HIBBS
DISTRICT PAW PAW COUNTY MARION STATE W.VA.
OTR QUADRANGLE BLKS. S.W. 2-4 DATE 10-8-29 NO. ON LEASE 2
LEASE EXPIRES 10-8-30 OBSERVATION ELEVATION 1274-L

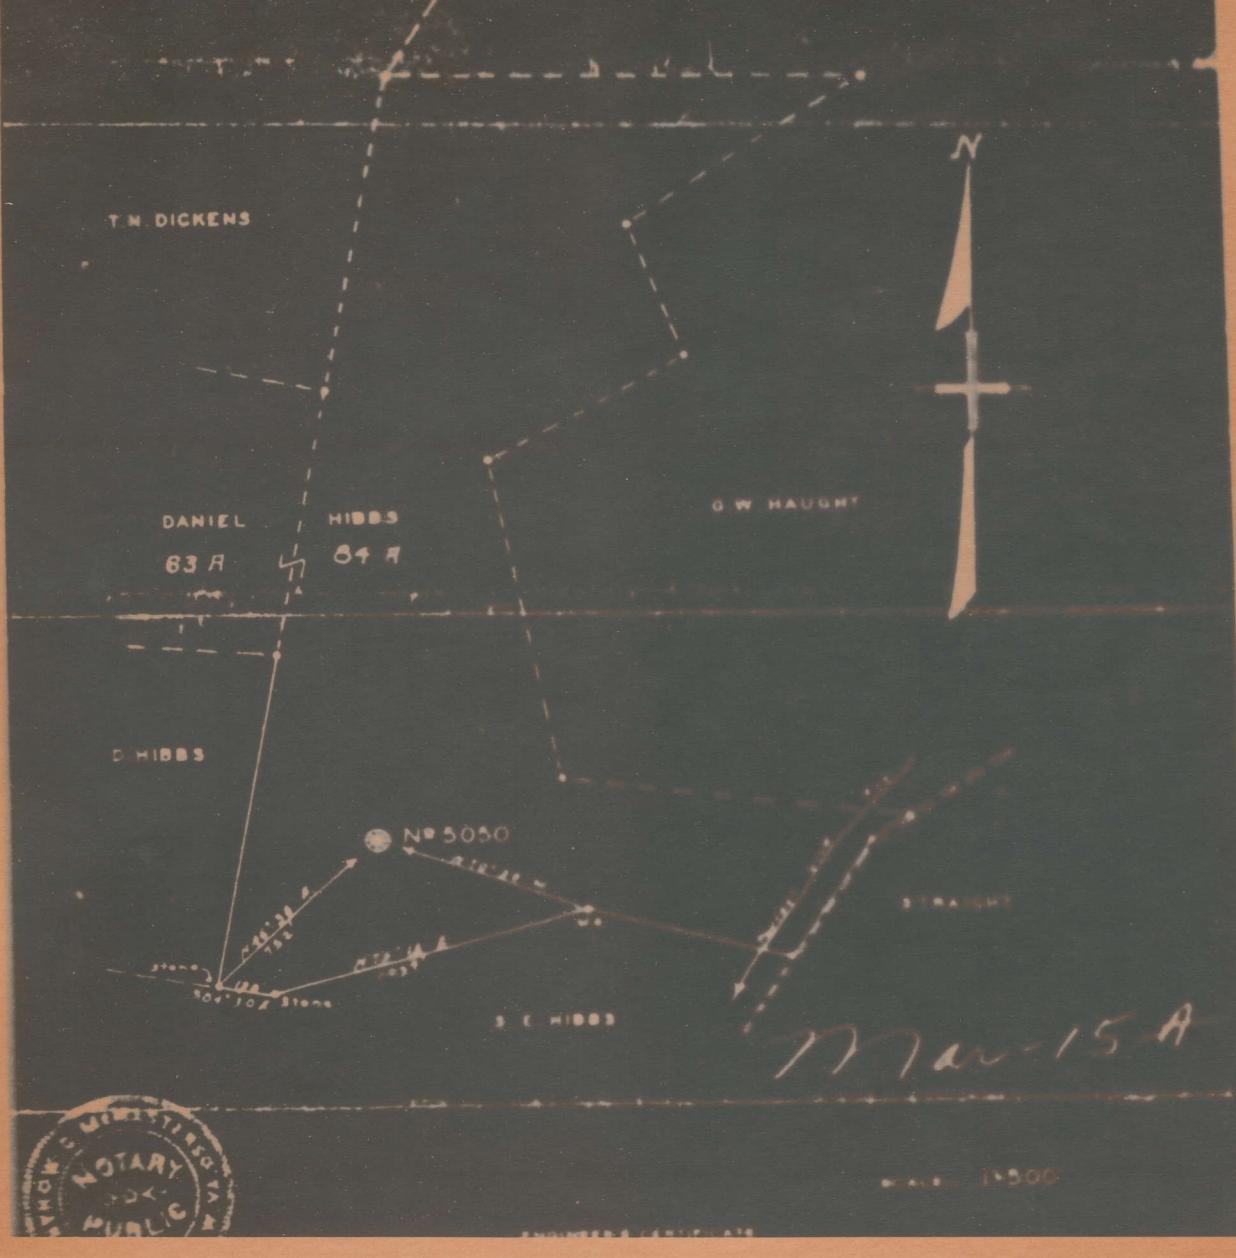

Paw Paw District, Marion County, W. Va.

By Pittsburgh & W. Va. Gas Co., 435 Sixth Ave., Pittsburgh, Pa.

On 147 acres, surface owned by Daniel Hibbs, R. F. D. No. 1,

Rivesville, W. Va., and mineral rights by The New England

Fuel & Transportation Co., Grant Town, W. Va., and Daniel

Hibbs, R. F. D. No. 1, Rivesville, W. Va.

Well completed Feb. 6, 1913.

Elevation, 1274' L.

13" conductor, 16"; 10" casing, 630'; 8 $\frac{1}{2}$ ", 1546'; 6-5/8", 1849'.

Coal was encountered at 200-205, 478-485, 587-596, 965-970, and

1165-1170'.

Abandonment reported to Dept. of Mines March 21, 1930.

Located Oct. 28, 1912; started drilling, Dec. 5, 1912; completed,

Feb. 6, 1913. Gas well in Big Injun and 5th Sands.

Well was shot in 5th Sand.

Salt water at 1518 and 1613'.

	Top.	Bottom.	Thickness.
Coal, Fairview (Waynesburg)	200	205	5
Coal, Sewickley	478	485	7
Coal, Pittsburgh	587	596	9
Sand, Murphy	755	770	15
Coal	965	960	5
Little Dunkard Sand	1058	1078	20
Big Dunkard Sand	1103	1163	60
Freeport Coal	1165	1170	5
Slate	1170	1190	20
Lime	1190		
Gas Sand	1305	1318	13
Sand, 1st Salt	1406	1445	39
Sand, 2nd Salt	1470	1480	10
Sand, 3rd Salt (water, 1518 and 1613')	1500	1613	113
Maxton Sand	1716	1743	23
Red rock	1743	1745	2
Lime	1745	1752	7
Red rock	1752	1801	49
Little Lime	1801	1816	15
Pencil Cave	1816	1826	10
Big Lime	1826	1895	69
Big Injun Sand (gas, 1910', 1990', and 2010')	1895	2047	152
Squaw Sand	2116	2170	54
30-Ft. Sand	2385	2481	96
Slate	2481	2487	6
50-Ft. Sand	2487	2560	73
Slate and shell	2560	2620	60
Gordon Stray Sand	2620	2649	29
Red rock	2649	2690	41
Sand	2690	2706	16
Red rock and shell	2706	2770	64
Gordon Sand	2770	2785	15
4th Sand	2827	2865	38
Slate and shell	2865	2955	90
Sand, 5th (gas, 2984')	2955	2986	31
Slate, to bottom	2986	2997	11

MAR-15-A