

LATITUDE 39 27 30

+ 1.35
.4 W

LONGITUDE 80 17 30

7'5 OGIS topo location

7.5' loc _____ 15' loc _____
(calc.) _____

Company _____

Farm LORA FOWLER 1810


Quad SHINNSTOWN

County MARION

District LINCOLN

WELL LOCATION MAP

File No. 30027

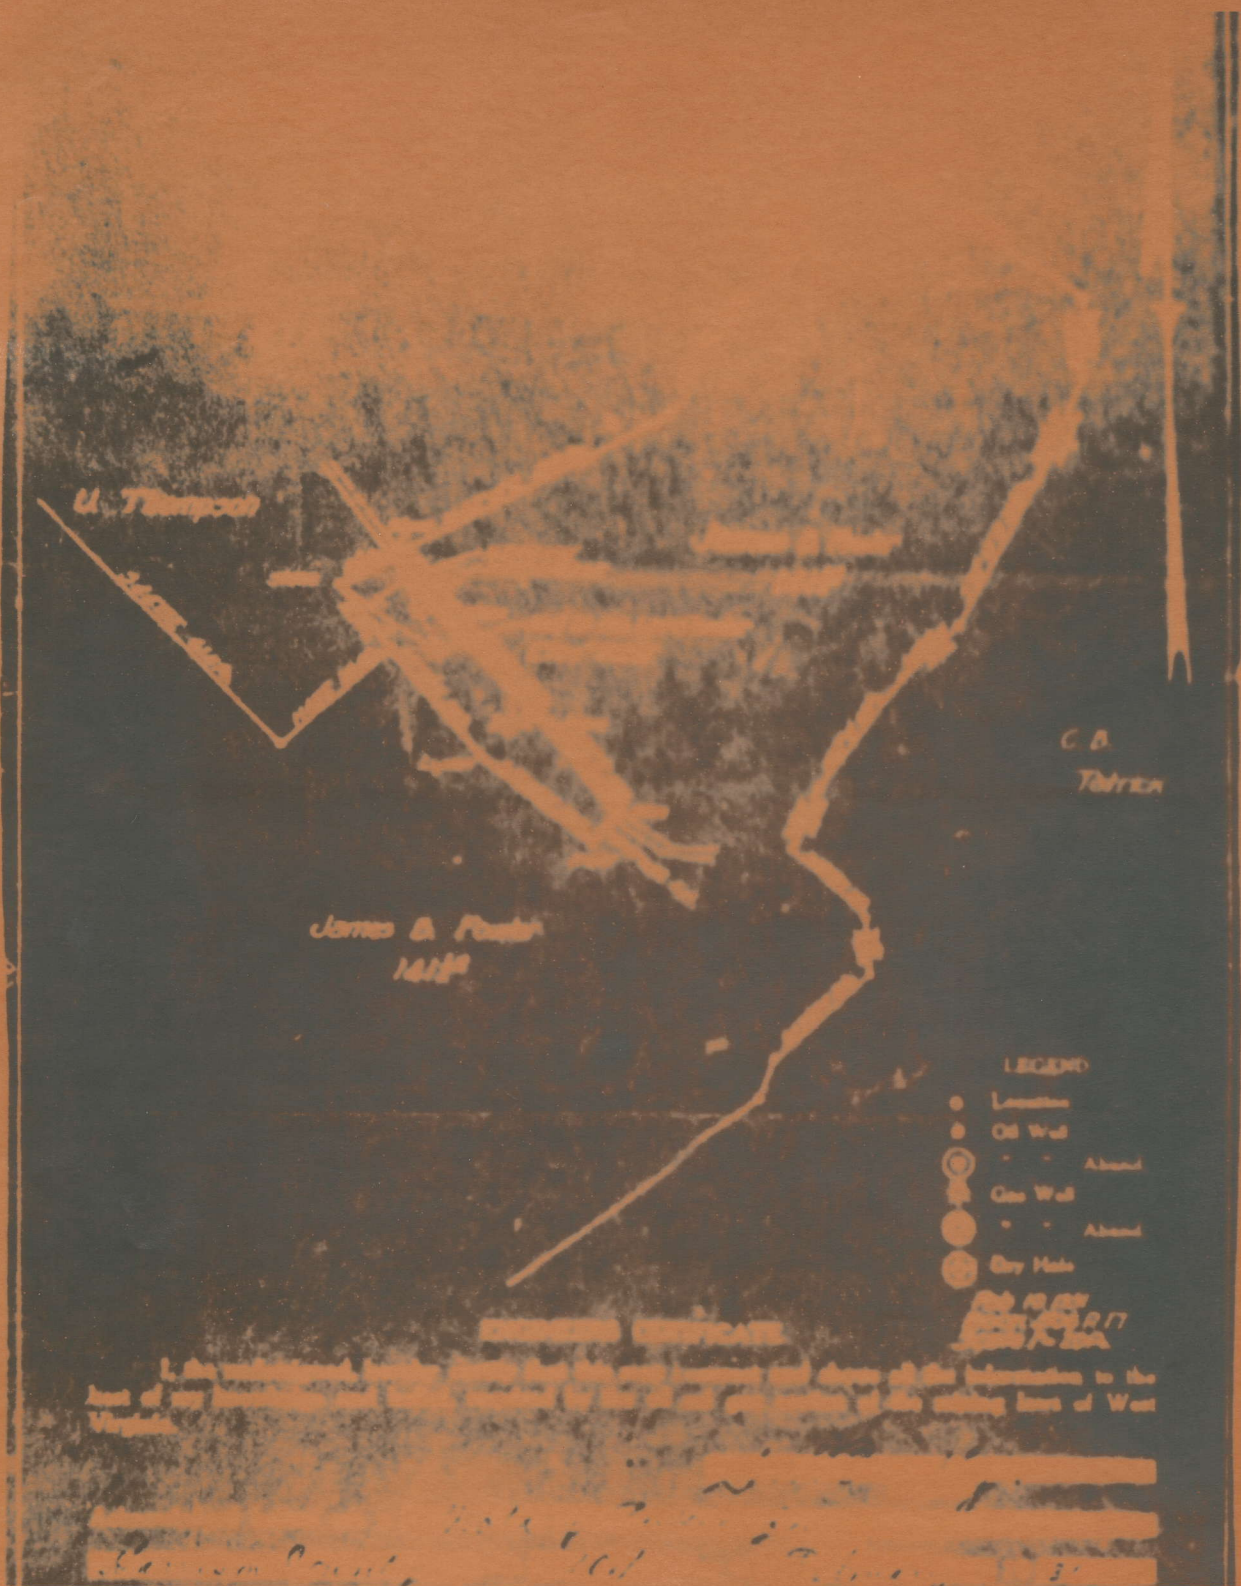

U. Thompson

C. B. TOTTEN

James A. Foster
1888

- LEGEND
- Location
 - Oil Well
 - Abandoned
 - Gas Well
 - Abandoned
 - Dry Hole

I, the undersigned, hereby certify that the above is a true and correct copy of the information to the best of my knowledge and belief, and that it is a true and correct copy of the existing lines of West Virginia.

S. W. 1/4
1888

Lincoln District, Marion County, W. Va.

By Hope Natural Gas Co., 445 W. Main St., Clarksburg, W. Va.

On 3 acres, surface owned by Lora Fowler, Route 1, Worthington,
W. Va., and mineral rights by George W. Sturm, West Milford,
W. Va.

Drilled prior to June 1, 1929.

Elevation, 908.61' L.

10" casing, 157'; 8 $\frac{1}{4}$ " casing, 1098'.

Coal was encountered at 90-100'.

Abandonment reported to Dept. of Mines Feb. 10, 1931. (Rec. to 1040').

Fresh water at 30'; salt water at 950'.

MAC-27-A

	Top.	Bottom.
Hole full of water at		30
Pittsburgh Coal	90 -	100
Little Dunkard Sand (10" casing, 157')	450 -	475
Big Dunkard Sand	605 -	750
Salt Sand	890 -	1040
(8 $\frac{1}{4}$ " casing set at 1098')		

(RECORD INCOMPLETE)