LONGITUDE 80 10

2,225 1.74W

7'5 OGIS topo location

7.5' loc _____ 15' loc _____ (calc.)


Company ____

Farm ___

County ____

District

WELL LOCATION MAP File No. 30045

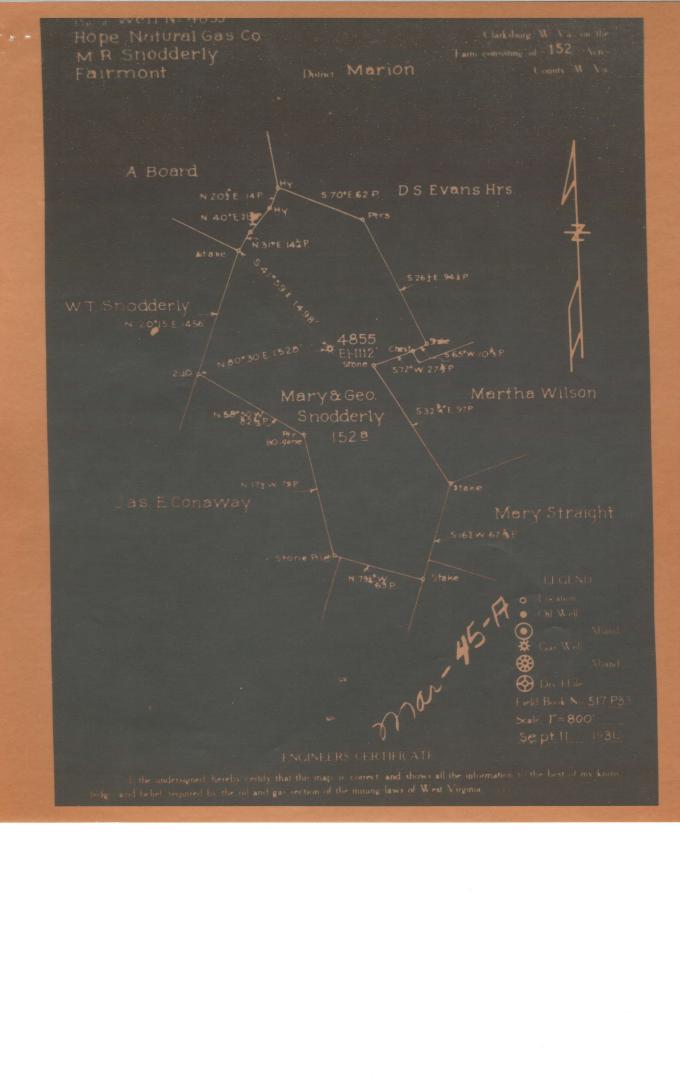

Fairmont District, Marion County, W. Va. By Hope Natural Gas Co., 445 W. Main St., Clarksburg, W. Va. On 152 acres, surface owned by Mary R. and George Snodderly,
Route 2, Fairmont, W. Va., and mineral rights by Bethlehem
Mines Corp., Barrackville, W. Va.
Drilled prior to June 1, 1931.(1929?) Elevation, 1112' L.

Elevation, 1112. L.

10" casing, 492'; 82", 1499'; 6-5/8", 1784'.

Coal was encountered at 290-296 and 422-430'.

10" casing cemented through Pittsburgh Coal.

Abandonment reported to Dept. of Mines Sept. 14, 1931.

Well was shot at 1777-1792. Salt water at 1350'.

Gas well; now exhausted to extent of not being commercially productive.

	Top. Bottom.
Native coal	290 - 296
Pittsburgh Coal (gas in Pgh. Coal)	422 - 430
Little Dunkard Sand	885 - 900
Big Dunkard Sand	965 - 980
Gas Sand	1050 - 1090
First Salt Sand	1230 - 1285
Second Salt Sand (water, 1350)	1330 - 1442
Little Lime	1690 - 1705
Pencil Cave	Not recorded
Big Lime	1712 - 1774
Big Injun Sand (gas, 1778-1788')	1774
Total depth	1895

MAR-45-A