7'5 OGIS topo location

7.5' loc _____ 15' loc _____ (calc.)

Company 4614


Farm ALICE S. THORN

Quad GRANT TOWN
County MARION

District PAW PAW

WELL LOCATION MAP

File No. 30061

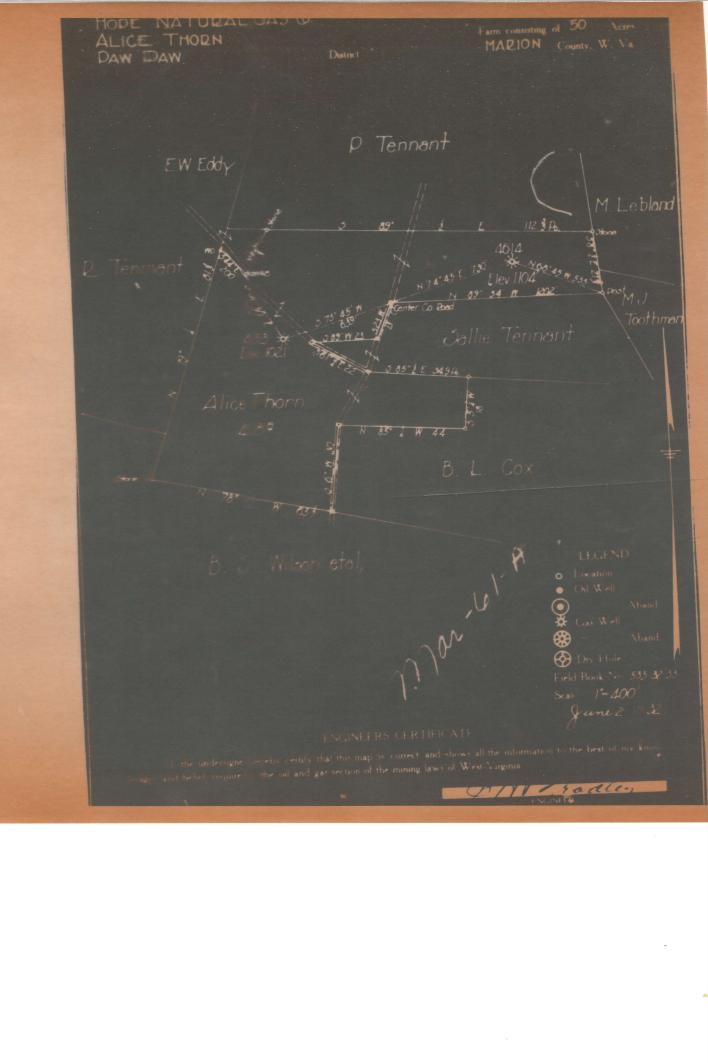

Paw Paw District, Marion County, W. Va.
By Hope Natural Gas Co., 445 W. Main St., Clarksburg, W. Va. On 50 acres, surface and mineral rights owned by Alice S. Thorn Heirs, %J. D. Thorn, Rivesville, W. Va.

Elevation, 1104: L.

10" casing, 437'; 8\frac{1}{2}", 1300'; 6-5/8", 1706'.

Coal was encountered at 364-368 and 421-425'.

Abandonment reported to Dept. of Mines June 3, 1932.

Well was not shot.

Fresh water at 60, 120, 210, 305, and 470; salt water at 1389.

Gas well; now exhausted to extent that it is not commercially

Water at 60 320 mg 3 7050	Top. Bottom.	Thickness.
Water at 60, 120, 210, and 305	-(1) -(
Native coal (Sewickley)	364 - 368 421 - 425	4
Pittsburgh Coal	421 - 425	4
Water at 470		
Little Dunkard Sand	827 - 848	21
Big Dunkard Sand	917 - 947	30
Gas Sand	1105 - 1140	30 35 24
First Salt Sand	1300 - 1324	5/1
Second Salt Sand (water, 13891)	1369 - 1490	21
Maxton Sand	1555 - 1590	25
Little Lime	1635 - 1665	30
Pencil Cave	1665 - 1672	7
Big Lime	1672 - 1735	63
Big Injun Sand (gas, 1744-1750')	1735	
Total depth	1755	

MAR-LOVA