


LATITUDE 3940

LONGITUDE 8025

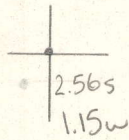

7'5 OGIS topo location

7.5' loc _____

15' loc _____
(calc.) _____

Company _____ 5273 _____

Farm W H SNYDER _____

Quad HUNDRED _____

County MARION _____

District MANNINGTON _____

WELL LOCATION MAP

File No. 30108 _____

LOCATION OF WELL NO 5273 TO BE ABANDONED


PITTSBURGH & W.VA. GAS COMPANY OF PITTSBURGH, PA.

LEASE NO 14793 LESSOR W.H. SNYDER ACRES 25

DISTRICT MANNINGTON COUNTY MARION STATE W.VA.

QTR QUADRANGLE MANNINGTON N.W. 34 DATE MARCH 20, 1935 NO ON LEASE

LEASE EXPIRES _____ F. RESERVATION _____ ELEVATION 1366 VA.

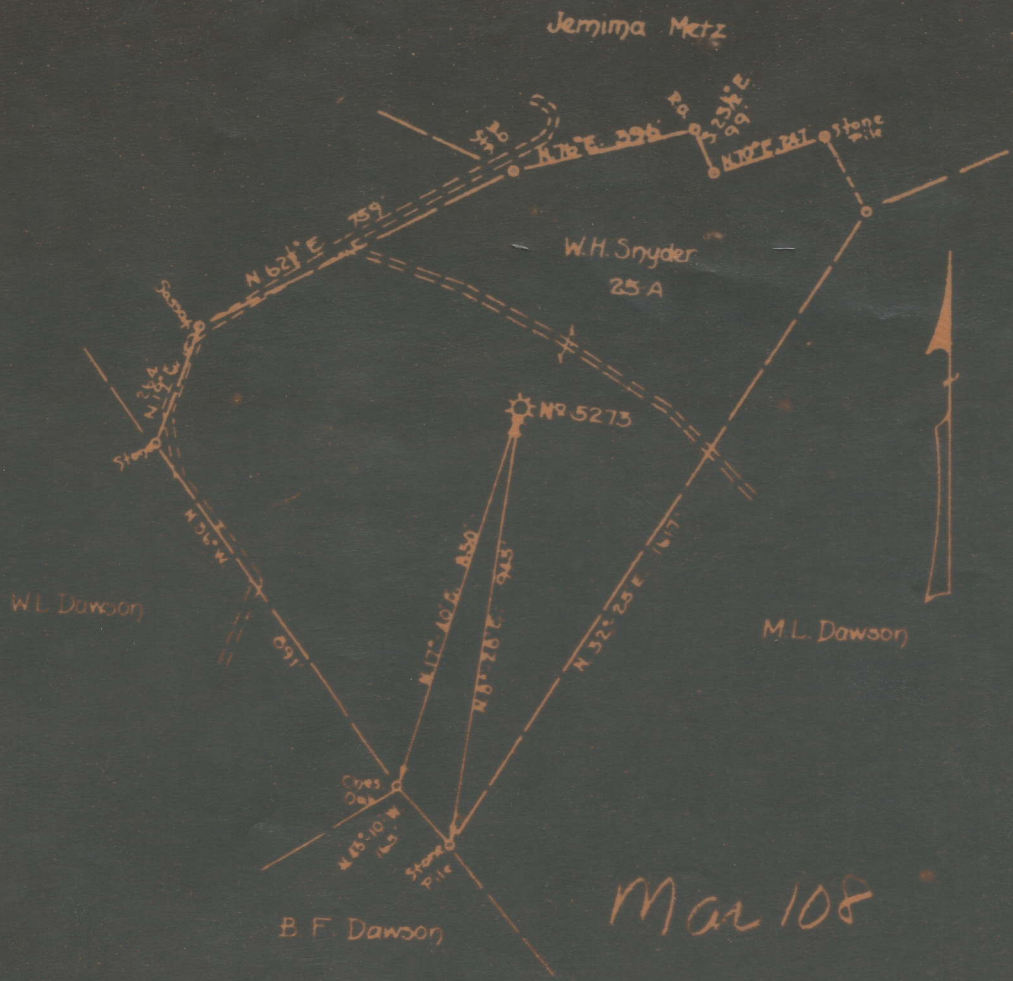

ENGINEER'S CERTIFICATE

SCALE - 1" = 300'

I, THE UNDERSIGNED, HEREBY CERTIFY THAT THIS MAP IS CORRECT AND SHOWS ALL THE INFORMATION TO THE BEST OF MY KNOWLEDGE AND BELIEF, REQUIRED BY THE OIL AND GAS SECTION OF THE MINING LAWS OF WEST VIRGINIA.

H. Bryan

MANNINGTON DISTRICT, MARION COUNTY, W. VA.
 By Pittsburgh & W. Va. Gas Co., Clarksburg, W. Va.
 On 25 acres, surface and mineral rights owned by W. H. Snyder,
 1015 E. Main St., Mannington, W. Va.
 Well was completed Sept. 22, 1918.
 Elevation, 1366' V.A.
 13" conductor, 16" casing, 230'; 8 1/2", 1618'; 6-5/8", 2388'.
 Coal was encountered at 751-755, 805-810, 1065-1070, 1130-1133,
 and 1165-1173'.
 Abandonment reported to Dept. of Mines March 19, 1935.
 Well located March 29, 1918; began drilling, August 5, 1918;
 completed drilling, Sept. 22, 1918.
 Fresh water at 120'; salt water at 1920'.
 6-5/8" hole.

	Top.	Bottom.	Thickness.
Unrecorded	0	20	20
Slate, dark, soft	20	50	30
Lime, dark, hard	50	100	50
Sandy slate, white, hard (water at 120')	100	130	30
Lime, white, hard	130	170	40
Slate, white, soft	170	200	30
Red rock, soft	200	220	20
Lime, white, hard	220	295	75
Slate, white, soft	295	340	45
Lime, white, hard	340	430	90
Red rock, soft	430	445	15
Lime, dark, hard	445	500	55
Slate, dark, soft	500	520	20
Sand, white, hard	520	550	30
Lime, white, hard	550	575	25
Sand, white, hard	575	600	25
Slate, dark, soft	600	620	20
Lime, dark, hard	620	660	40
Slate, dark, soft	660	675	15
Lime, white, hard	675	710	35
Slate, white, soft	710	720	10
Lime, white, hard	720	751	31
Coal, black, soft	751	755	4
Lime, dark, hard	755	780	25
Bluff Sand, white, hard	780	805	25
Fairview (Waynesburg) Coal, black, soft	805	810	5
Lime, white, hard	810	865	55
Sand, white, hard	865	900	35
Lime, dark, hard	900	1065	165
Mapletown (Sewickley) Coal, black, soft	1065	1070	5
Lime, dark, hard	1070	1130	60
Graham (Redstone) Coal, dark, soft	1130	1133	3
Lime, dark, hard	1133	1165	32
Pittsburgh Coal, black, soft	1165	1173	8
Lime, dark, hard	1173	1230	57
Red rock, soft	1230	1240	10
Lime, white, soft	1240	1285	45
Murphy Sand, white, hard	1285	1310	25
Slate, white, soft	1310	1325	15
Lime, white, hard	1325	1360	35
Red rock, soft	1360	1370	10

(OVER)

MAR-108-A

