


LATITUDE 39 30

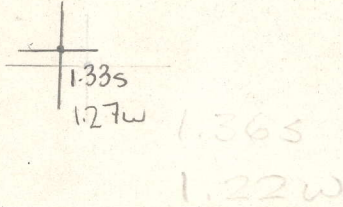

LONGITUDE 80 22 30

7'5 OGIS topo location

7.5' loc _____ 15' loc _____
 _____ (calc.) _____

Company _____

Farm B F HELDRETH 2

Quad WALLACE

County MARION


District MANNINGTON

WELL LOCATION MAP

File No. 30111

Earl Smith
formerly
Jacob L. Price

Scale 1/4" = 400'

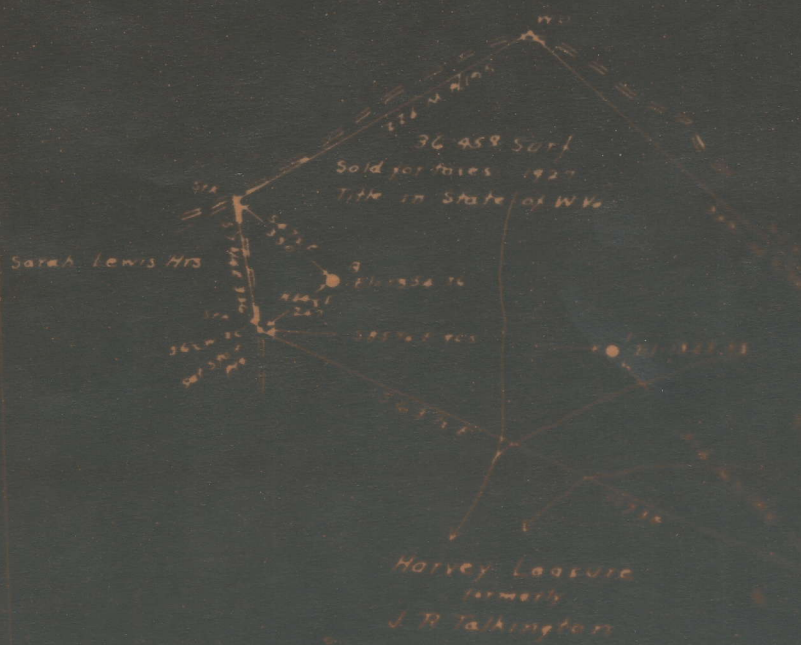

Coal part of 110,924 assessed to Phillip Brown et al
and Stern Bros Inc et al - Uniontown, Pa

South Penn Oil Co
Survey for abandonment of Wells No. 1, 2, & 3
B F Heldtth - head of Quaker Run at Uniontown, Pa
Mannington Dist Marion Co, W. Va. - 8-1-27

M. J. Smith

Mannington District, Marion County, W. Va.
 By South Penn Oil Co., Chamber of Commerce Bldg., Pittsburgh, Pa.
 On 40 acres, surface owned by State of West Virginia, Charleston,
 W. Va, and mineral rights by B. F. Heldreth Heirs et al.,
 H. A. Harbert, Lumberport, W. Va.

Elevation, 1458.89' L.

16' conductor; 10" casing, 270' (pulled); 8 $\frac{1}{2}$ "¹¹, 1717'; 6-5/8"¹¹, 2735'.

Coal was encountered at 1345-1350'.

Liner: 677' of 4 $\frac{1}{2}$ " x 4"¹¹.

Abandonment reported to Dept. of Mines May 3, 1935.

Well was shot in Stray Sand, Dec. 17, 1910, with 40 qts.; and
 June 14, 1904, with 30 qts.

Oil well.

	Top.	Bottom.
Pittsburgh Coal	1345	- 1350
Big Dunkard Sand	1845	- 1920
Salt Sand	2250	- 2350
Big Lime	2565	- 2645
Big Injun Sand	2645	- 2730
Fifty-foot Sand	3245	- 3275
Stray Sand (oil, 3403')	3359	- 3434
Slate	3434	- 3440
Gordon Sand	3440	- 3469
Slate, to bottom	3469	- 3474

MAR-111-A