1,345 .30W

LONGITUDE

00

27

7'5 OGIS topo location

7.5' loc \_\_\_\_\_ 15' loc \_\_\_\_\_ (calc.)

Company 1492


Farm OJ CUNNINGHAM

QUAD GLOVER GAP
County MARION

District MANNINGTON

WELL LOCATION MAP

File No. 30116

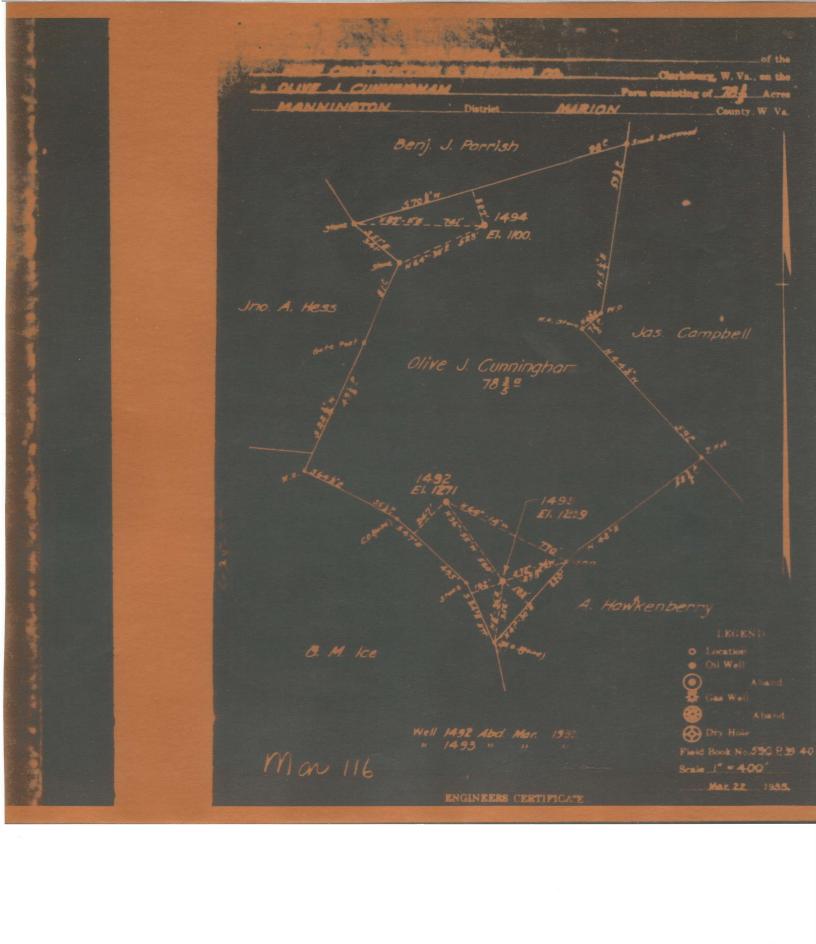

116A

Mannington District, Marion County, W. Va. Hope Cons. & Ref. Co., 445 W. Main St., Clarksburg, W. Va. On 78-3/5 acres, surface owned by Charles Cunningham, Route 6, Mannington, W. Va.; coal owner, unknown. Elevation, 1209 L. 82" casing, 1524; 6-5.5", 1989; 5-3/16", 2960; 2" tubing, 3193'. Coal was encountered at 945-950 and 1040-1050'. Abandonment reported to Dept. of Mines June 24, 1935. Well was shot at 2384 and 3188-31951. Water not recorded. Oil well. Now exhausted to extent it is no longer commercially productive.

Top. Bottom. 945 - 950 Native coal 1040 - 1050 1520 - 1575 Pittsburgh Coal Big Dunkard Sand 1805 - 1835 Gas Sand 1914 - 1980 First Salt Sand Second Salt Sand 1987 - 2130 2150 - 2237 Maxton Sand 2237 - 2324 Big Lime Big Injum Sand (oil, 2384-23891) 2598 - 2620 2836 - 2850 2960 - 2998 Squaw Sand Gantz Sand 50-Ft. Sand 3062 - 3082 3120 - 3134 3175 - 3215 30-Ft. Sand Gordon Stray Sand Gordon Sand (oil and gas, 3191') 3215 Total depth