

LATITUDE 39 35

LONGITUDE 80 27 30

+  
1.44S  
-65W

7'5 OGIS topo location

7.5' loc \_\_\_\_\_

\_\_\_\_\_

15' loc \_\_\_\_\_  
(calc.) \_\_\_\_\_

Company 360

Farm J W KENDALL

Quad GLOVER GAP

County MARION

District MANNINGTON

WELL LOCATION MAP

File No. 30119

Plot of WELLS NO 359 & 360

HOPE CONSTRUCTION & REFINING CO.

J.W. KENDALL


MANNINGTON

District

MARION

of the  
Clarksburg, W. Va. on the  
Farm consisting of 158 Acres

County, W. Va.

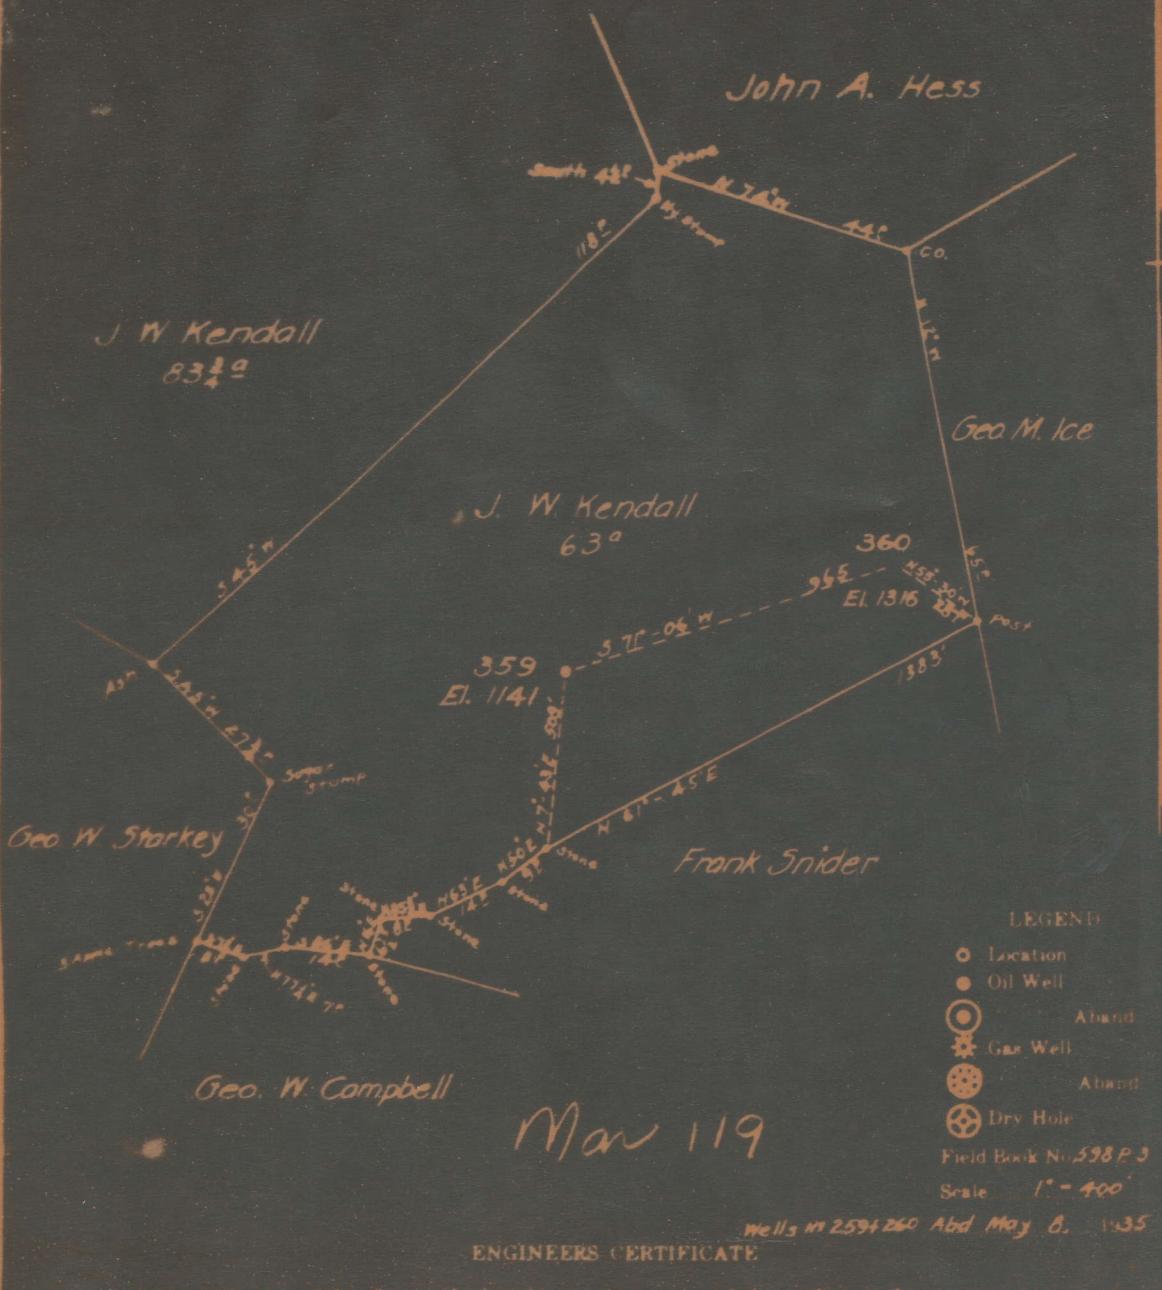

Mannington, W. Va., Marion County, W. Va.  
 By Hope Construction & Refining Co., 445 W. Main St.,  
 Clarksburg, W. Va.

On 158 acres, surface owned by J. B. Lazear, Mannington, W. Va.;  
 coal owner, unknown.

Elevation, 1316' L.

10" casing, 1416"; 8 $\frac{1}{2}$ ", 2170"; 6-5/8", 2379"; 2" tubing, 2520".

Coal was encountered at 620-625 and 1130-1137'.

Abandonment reported to Dept. of Mines July 11, 1935.

Well was shot at 2489-2499'.

Salt water at 2040-2045'.

Oil well; exhausted.

*MAR-19-A*

	Top.	Bottom.	Thickness.
Native Coal	620	625	5
Pittsburgh Coal	1130	1137	7
Little Dunkard Sand	1490	1528	38
Big Dunkard Sand	1625	1685	60
Gas Sand	1700	1818	118
First Salt Sand	1840	1875	35
Second Salt Sand (water, 2040-2045')	2007	2052	45
Maxton Sand	2250	2332	82
Big Lime	2335	2410	75
Big Injun Sand (oil, 2489-2500')	2410		
Total depth		2505	