


LATITUDE 39 35

LONGITUDE 80 17 30

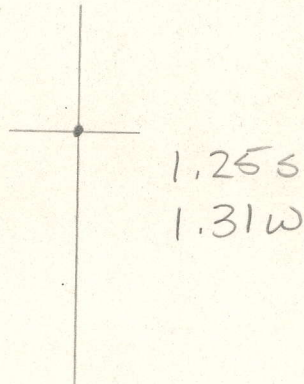

7'5 OGIS topo location

7.5' loc _____ 15' loc _____
 _____ (calc.) _____

Company _____

Farm S T TOOTHMAN 2

Quad MANNINGTON

County MARION

District LINCOLN

WELL LOCATION MAP

File No. 30132

West Virginia, on the Land of the Heirs
of Silas T. Touchman, containing 100 acres,
in Lincoln District, Marion County, West
Virginia.



I, the undersigned hereby certify this map is
correct, and shows all the information to the
best of my knowledge, as required by the
Oil and Gas section of the Mining Law
of West Virginia. David Weed, Engineer.
Acknowledged before me a Notary Public,
this 21st day of April - 1936.

DAR ymd

My commission expires the 11th day of

Unknown COAL OPERATOR OR OWNER
J. O. Cochran NAME OF WELL OPERATOR
Parkersburg, West Va. COMPLETE ADDRESS
 ADDRESS
 ADDRESS
 ADDRESS
19 WELL AND LOCATION
Lincoln District
Marion County
 Well No. **2**
S. T. Southman Town

AFFIDAVIT TO BE MADE IN TRIPlicate, ONE COPY TO BE MAILED BY REGISTERED MAIL TO THE DEPARTMENT, ONE COPY TO BE OBTAINED BY WELL OPERATOR AND THE THIRD COPY (AND EXTRA COPIES IF REQUIRED) TO BE MAILED TO EACH COAL OPERATOR ABOVE NAMED AT THEIR RESPECTIVE ADDRESSES.

AFFIDAVIT

STATE OF WEST VIRGINIA,
COUNTY OF **Marion**

being first duly sworn according to law depose and say that they are experienced in the work of plugging

and filling oil and gas wells and were employed by _____, well operator, and participated in the work of plugging and filling the above well, that said work was commenced on the **5th** day of **May**, 19**36**, and that the well was plugged and _____ in the following manner:

Manner in which said well was plugged: **Fill with red clay from 2025' - 2000' - 20' above the salt to cement - 2025' - 2000' sealing hole above Big Injun.**

FULL 2-1/2 casing on the hole is filled; Continue to fill with red clay from 2025' to 2000' - 20' above the salt to cement, above used plug 1947' - 1947'; Cement 1947' - 1947' sealing the hole; Continue to fill with red clay from 1947' to 1940' - 15' below the 2-1/2 casing and bottom of Big Injun. Steel line. Fill with red clay to 1940' - 1940' cement 1947' - 1947' sealing hole. Full casing.

IF COAL COMPANY DESIRES A WHITE CEMENT to be provided; Cement 1925' - 1925' - 20' above the Pittsburgh coal. Fill with red clay from 1925' to 1925'; Cement from 1925' to 1925' sealing the hole.

Continue to fill with red clay to 1925' - 15' below the 2-1/2 casing, above used plug 1947' to 1947'. Steel line. Cement 1947' to 1947' sealing the hole. Fill with red clay to the surface and erect a mark or cap as to Government in Rule 15, 1932 regulations. Cement 20' high.

and that the work of plugging and filling said well was completed on the **19** day of **June**, 19**36**.

And further deponents saith not.

Marion B Kennedy
Robert Moorhead
 23 day of **July** 19**36**

