


LATITUDE 39° 35'

LONGITUDE 80° 20'

GEO BAKER

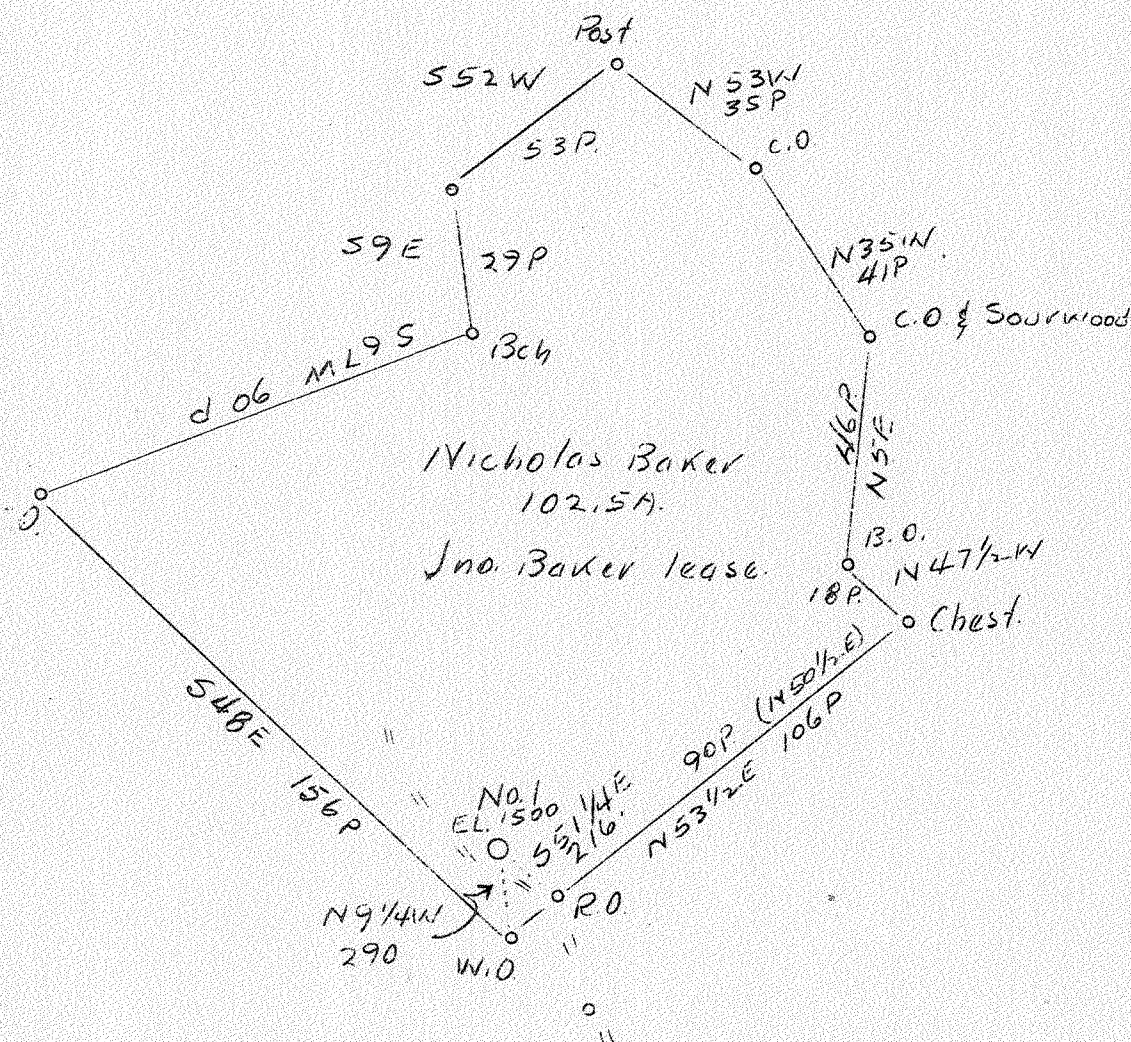

Nicholas Baker 102.5A.

Jno. Baker lease.

Coal not operated

4.29W 4.35W
0.235 0.23

Abd.

OCT - 9 1939

50

Company	William Moses
Address	Salem, W. Va.
Farm	Nicholas Baker
Acres	102.5
Well (Farm) No.	1
Elevation (SL)	1500
Quadrangle	Mannington
County	Marion
District	Mannington
Engineer	C. C. Fittro, C. E.
Eng. Reg. No.	818
File No.	XYZ
Drawing No.	132
Date	Sept. 20, 1939
Scale	40 poles - 1"

STATE OF WEST VIRGINIA
 Department of Mines
 OIL & GAS DIVISION
 Charleston

WELL LOCATION MAP
 File No. MAR-231A

x Denotes location of well on U. S. Topographic Maps, scale 1 to 62,500, latitude and longitude lines being represented by border lines as shown.

- Denotes one inch spaces on border line of original tracing.

STATE OF WEST VIRGINIA
DEPARTMENT OF MINES
OIL AND GAS DIVISION

376

WELL RECORD

Permit No. 291-A

Oil or Gas Well.....
(Kind)

Company..... <u>William Moses</u>	Casing and Tubing	Used in Drilling	Left in Well	Packers
Address..... <u>97 W. High St., Salem, W. Va.</u>	Size			
Farm..... <u>Nicolas Baker</u> Acres..... <u>102.5</u>	16			Kind of Packer.....
Location (waters).....	13			Size of.....
Well No..... <u>1</u> Elev..... <u>1500'</u>	10			Depth set.....
District..... <u>Mannington</u> County..... <u>Marion</u>	8 1/4		<u>2195'</u>	Perf. top.....
The surface of tract is owned in fee by..... <u>Nicolas Baker</u>	6 3/8		<u>2850'</u>	Perf. bottom.....
Mineral rights are owned by..... <u>Nicolas Baker</u>	5 3/16			Perf. top.....
Address..... <u>Mannington, W. Va.</u>	3			Perf. bottom.....
Drilling commenced.....	2		<u>3100'</u>	
Drilling completed.....	Liners Used.....			
Date shot..... Depth of shot.....				
Open Flow /10ths Water in..... Inch				
/10ths Merc. in..... Inch				
Volume..... Cu. Ft.	CASING CEMENTED.....	SIZE.....	No. Ft.....	Date.....
Rock Pressure..... lbs..... hrs.				
Oil..... bbls., 1st 24 hrs.	COAL WAS ENCOUNTERED AT.....	FEET.....	INCHES.....	
Fresh water..... feet..... feet	<u>735</u> FEET.....	INCHES.....	<u>1075</u> FEET.....	INCHES.....
Salt water..... feet..... feet FEET.....	INCHES..... FEET.....	INCHES.....

Formation	Color	Hard or Soft	Top	Bottom	Oil, Gas or Water	Depth Found	Remarks
Mapletown Coal <u>Wagonwheel</u>			735	741			
Pittsburgh Coal			1075	1082			
Big Dunkard			1457	1492			
2nd Salt Sand			1687	1772			
Big Injun			2195	2287			
ty Foot Sand			2755	2777			
Thirty Foot Sand			2853	2878			
Stray Sand			3028	3062			
Gordon Sand			3082	3100			
Total Depth	3123						



Formation	Color	Hard or Soft	Top	Bottom	Oil, Gas or Water	Depth Found	Remarks

Date....., 19.....

APPROVED W W Moses....., Owner

By..... (Title)