

Latitude

Longitude

1.85s
1.17w

Topo Location

7.5' Loc. _____ 15' Loc. _____
 _____ (calc.) _____

Company Hope

Farm TJ Millam #915


15' Quad _____
(sec.)

7.5' Quad Shinnston

District Lincoln

WELL LOCATION PLAT

County 049 Permit 30288

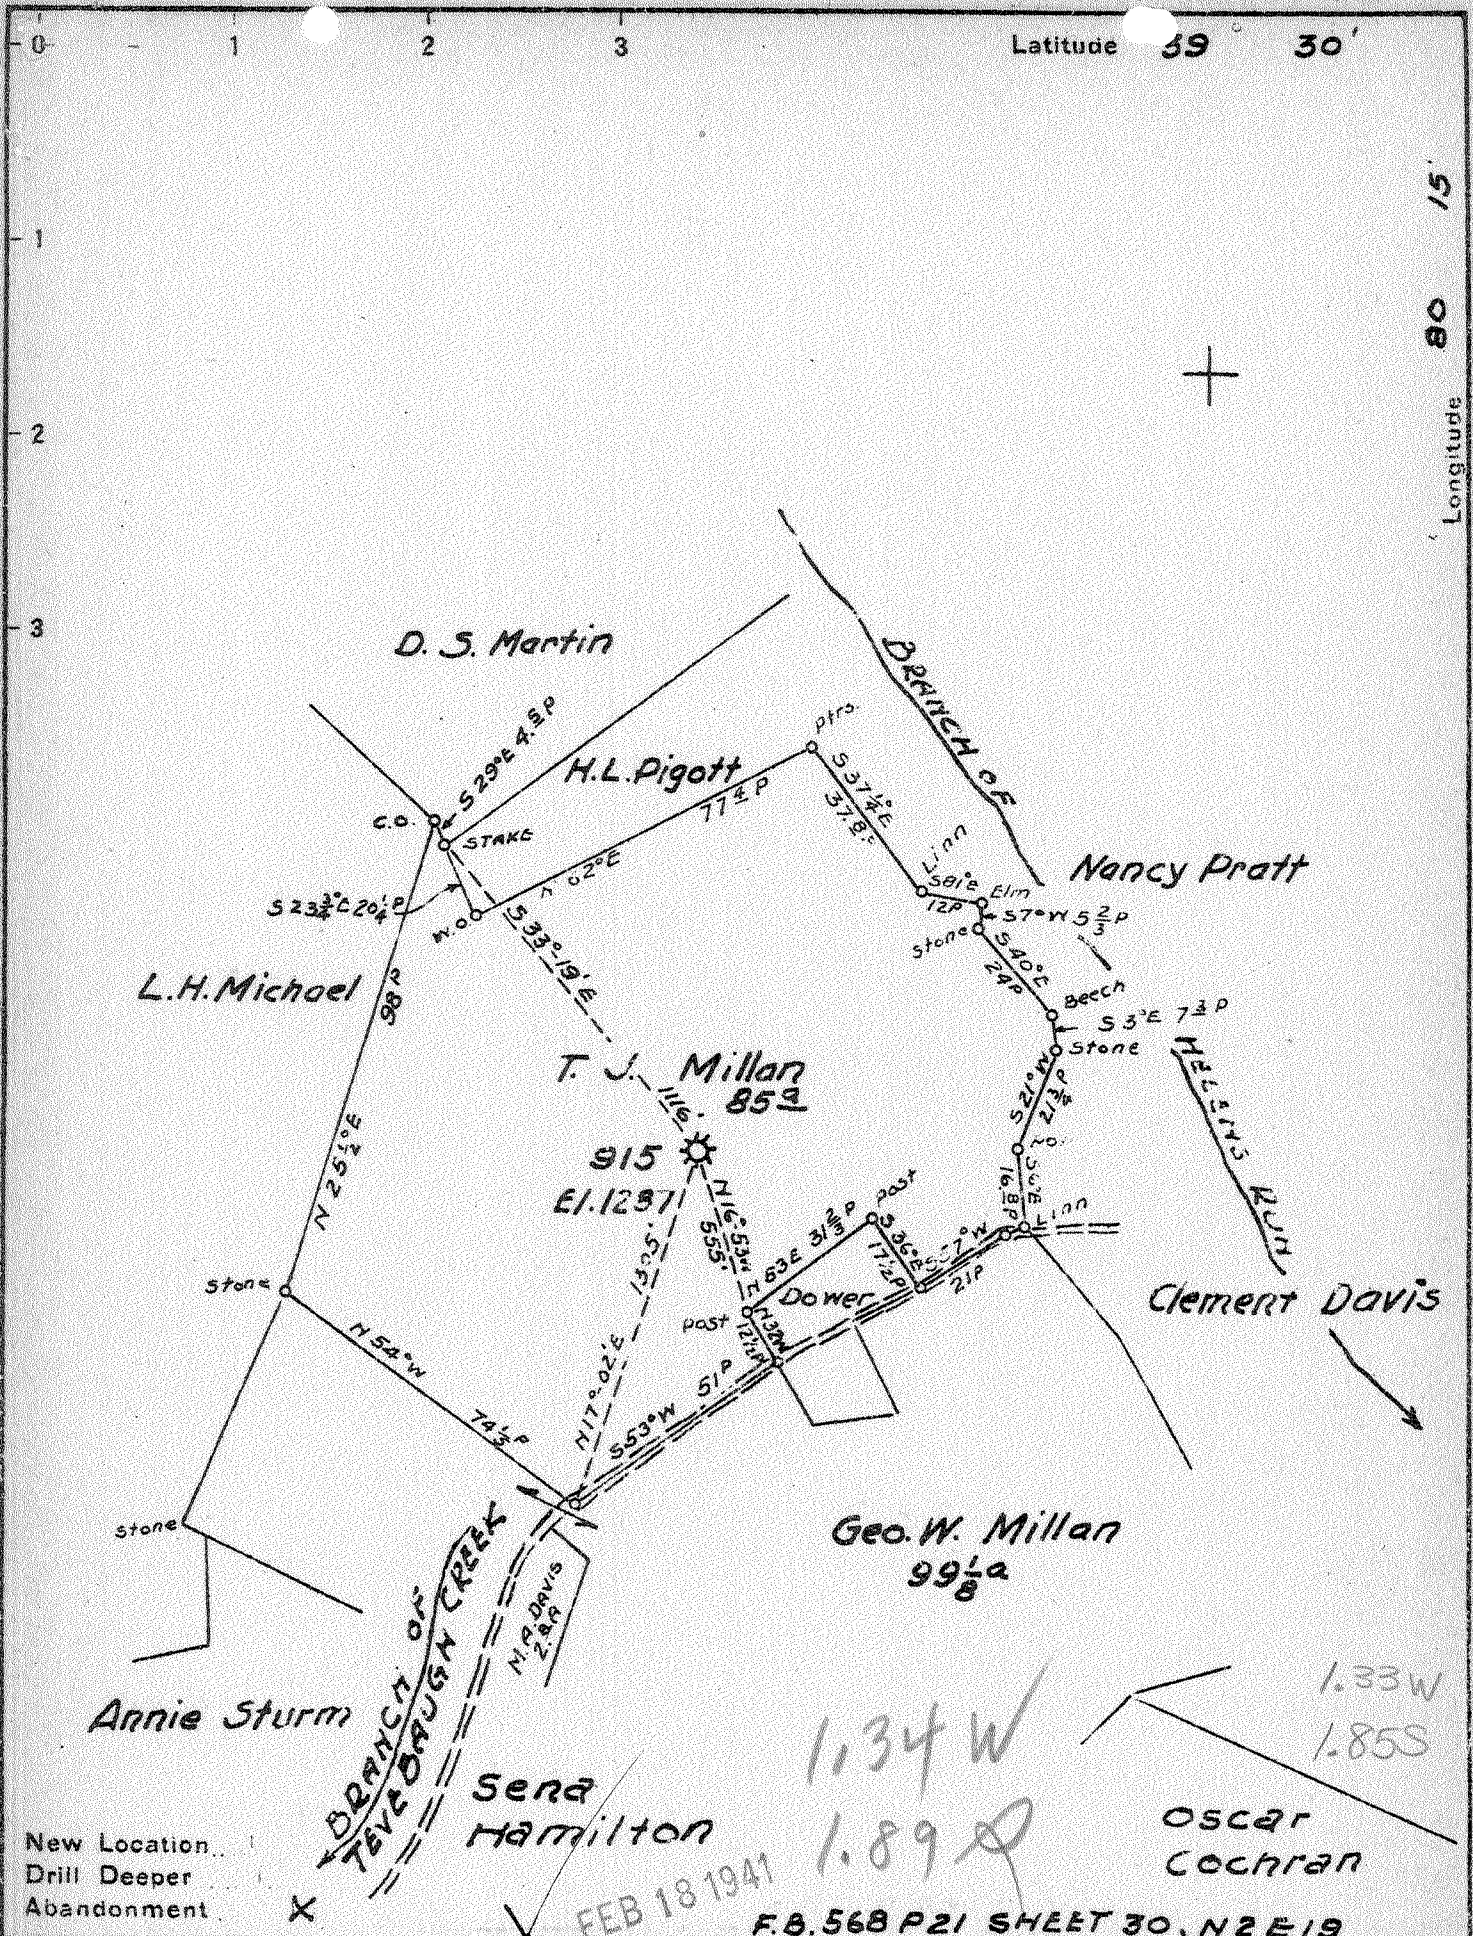

New Location
 Drill Deeper
 Abandonment

Company HOPE NAT. GAS CO.
 Address CLARKSBURG, W.VA.
 Farm T.J. MILLAN
 Tract _____ Acres 90 Lease No. 956
 Well (Farm) No. _____ Serial No. 915
 Elevation (Spirit Level) 1287
 Quadrangle CLARKSBURG
 County MARION District LINCOLN
 Engineer W.M. Bowers
 Engineer's Registration No. 900
 File No. _____ Drawing No. _____
 Date 2-5-1941 Scale 1"=40 FEET

STATE OF WEST VIRGINIA
 DEPARTMENT OF MINES
 OIL AND GAS DIVISION
 CHARLESTON

WELL LOCATION MAP
 FILE NO. MAR-288A

+ Denotes location of well on United States Topographic Maps, scale 1 to 62,500. latitude and longitude lines being represented by border lines as shown.
 - Denotes one inch spaces on border line of original tracing

STATE OF WEST VIRGINIA
DEPARTMENT OF MINES
OIL AND GAS DIVISION

381

WELL RECORD

Ab 288-A
Permit No. 288-A

Oil or Gas Well Gas
(KIND)

Company Hope Natural Gas Company
Address Clarksburg, W. Va.
Farm T. J. Millan Acres 90
Location (waters) Tevebaugh Creek
Well No. 915 Elev. 1287
District Lincoln County Marion
The surface of tract is owned in fee by Consolidation Coal Co.
Address Fairmont, W. Va.
Mineral rights are owned by _____
Address _____
Drilling commenced 2-8-1907
Drilling completed 4-12-1907
Date shot 5-5-1908 Depth of shot 5th sand
Open Flow /10ths Water in _____ Inch
/10ths Merc. in _____ Inch
Volume _____ Cu. Ft.
Rock Pressure _____ lbs. _____ hrs.
Oil None recorded bbls., 1st 24 hrs.
Fresh water 1525 feet _____ feet
Salt water _____ feet _____ feet

Casing and Tubing	Used in Drilling	Left in Well	Packers
Size			
16			Kind of Packer
13			
10	600	Pulled	Size of
8 1/4	1554	1554	
6 5/8	1926	1926	Depth set
5 3/16	2858	2858	
3			Perf. top
2	3172	Pulled	Perf. bottom
Liners Used			Perf. top
			Perf. bottom

CASING CEMENTED _____ SIZE _____ No. Ft. _____ Date _____
Not cemented
COAL WAS ENCOUNTERED AT 456 FEET _____ INCHES
579 FEET _____ INCHES _____ FEET _____ INCHES
_____ FEET _____ INCHES _____ FEET _____ INCHES

Formation	Color	Hard or Soft	Top	Bottom	Oil, Gas or Water	Depth Found	Remarks
Mapletown Coal			456	No record			
Pittsburgh Coal			579	No record			
Little Dunkard Sand			940	965			
Big Dunkard Sand			1070	1120			
Gas Sand			1330	1390			
Salt Sand			1475	1600	Water	1525	
Pencil G ave			1885	1890			
Big Lime			1890	1965			
Big Injun Sand			1965	2065			
Fifty Foot Sand			2425	2455			
Thirty Foot Sand			2470	2600			
Gordon Sand			2760	2787			
Fourth Sand			2830	2840			
Fifth Sand			2946	2972	Gas	2946-2964	
Total Depth			3140				

