


049-30328



LATITUDE 39 35

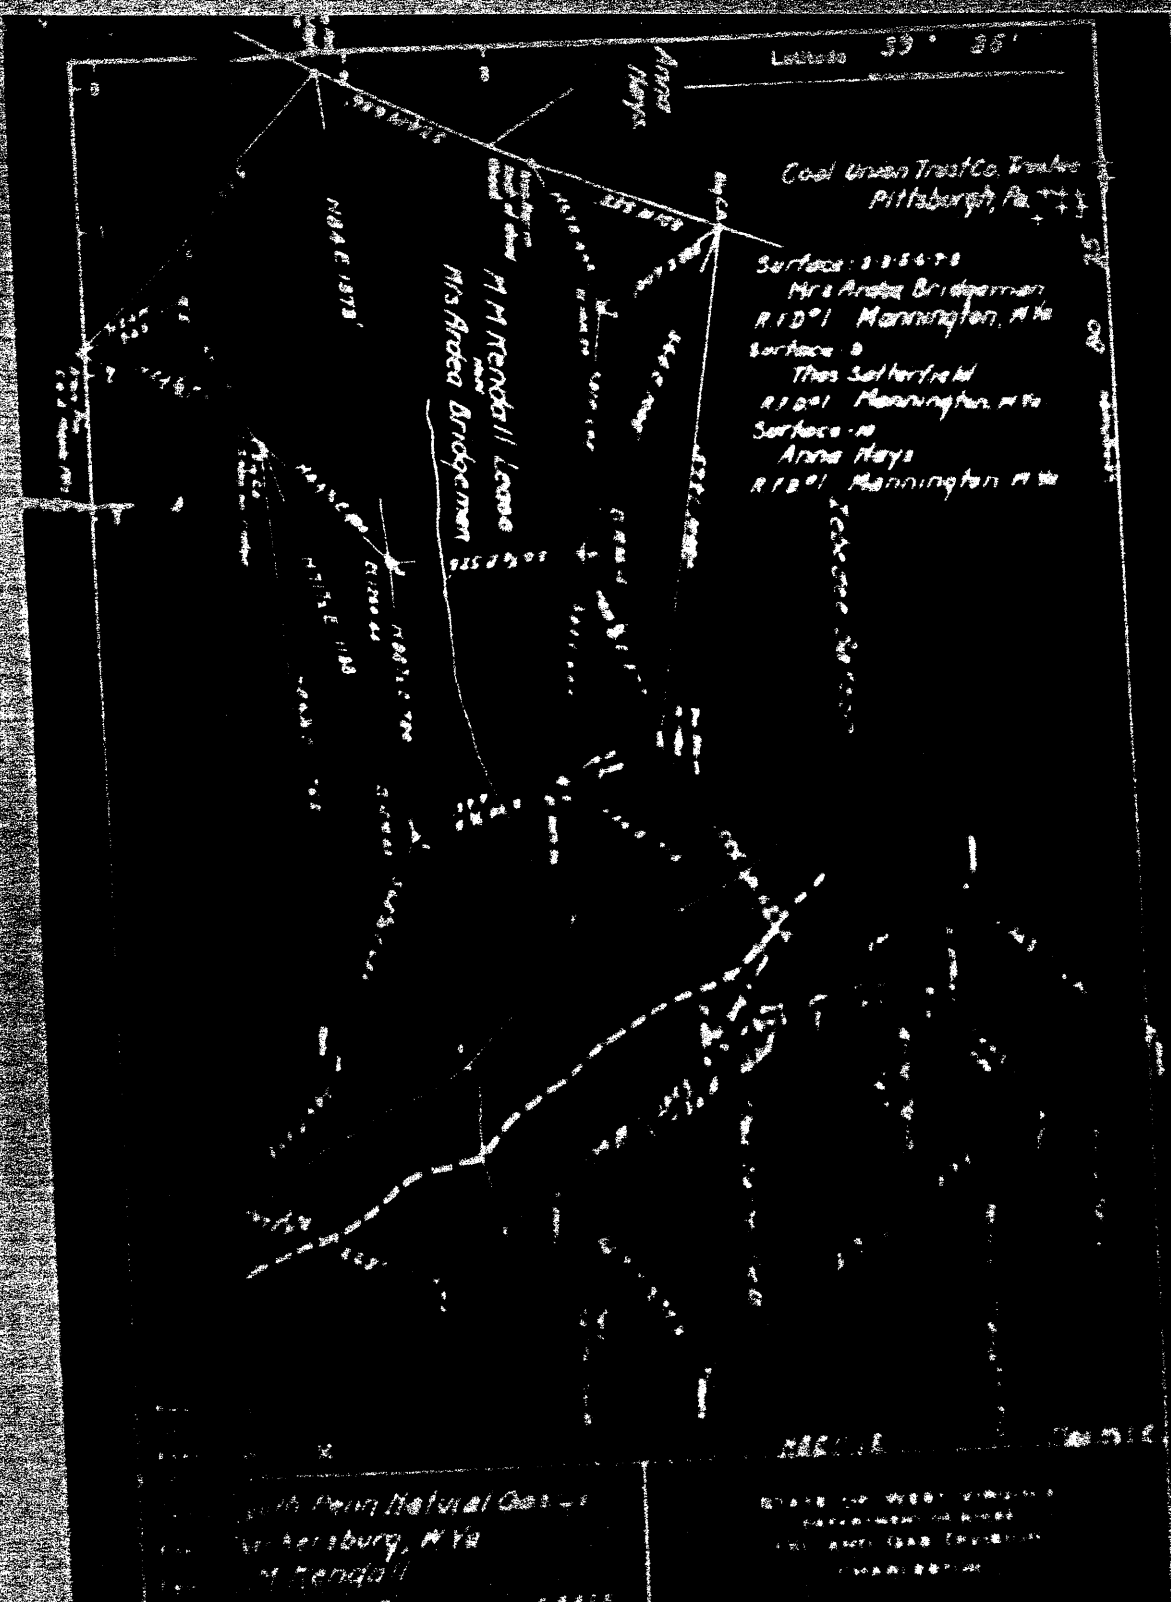

1.18s  
• 28w

LONGITUDE 80 25

7'5 OGIS topo location

7.5' loc \_\_\_\_\_ 15' loc \_\_\_\_\_  
(calc.) \_\_\_\_\_

Company \_\_\_\_\_

Farm MM KENDALL 7

Quad GLOVER GAP

County MARLBOROUGH

District WINDMILLTON

WELL LOCATION MAP

File No. 30328



Formation	Color	Hard or Soft	Top	Bottom	Oil, Gas or Water	Depth Found	Remarks

Date **November 13, 1941**, 194...

APPROVED **SOUTH PENN NATURAL GAS COMPANY**, Owner

By *Elton Young* Land Agent  
(Time)

Marion District, Marion County, W. Va.  
 By South Penn Natural Gas Co., Union Trust Bldg., Parkersburg, W. Va.  
 Abandoned under permit No. -----A7  
 In 127 acres, on Bents Run.  
 Elevation, 1311.25' l.  
 Surface owned by Mrs. Arden Bridgeman, R. F. D. No. 1, Marionton,  
 W. Va., and minerals by W. H. Merrill et al., 130 First St.,  
 Atkins, W. Va.  
 Drilling commenced Sept. 29, 1916; completed, Feb. 9, 1917.  
 Shot Feb. 20, 1917, with 20 qts., in 30-ft. Sand; Feb. 25, 1920,  
 with 30 qts., in 30-ft. Sand.  
 Oil, 5 bbls., 1st 24 hrs.  
 Fresh water at 1740'.  
 Salt water at 1835 and 1965'.  
 2 1/2" casing, 375' (pulled); 2 1/2", 1591' (pulled); 6", 2311';  
 5", 2651'; conductor, 16'.  
 Coal was encountered at 955-962 and 1050-1056'.  
 Oil well. Abandonment reported to Dept. of Mines Nov. 13, 1941.  
 Record to NCF from Mrs. Griffith Dec. 9, 1941. Old file No. 408.

	Top.	Bottom.
Appletown (Sovickley) Coal	955	- 962
Pittsburgh Coal	1050	- 1056
Little Dockard Sand	1160	- 1500
Sand	1575	- 1620
Gas Sand (water, 1740')	1725	- 1805
1st Salt Sand (water, 1835')	1820	- 1950
2nd Salt Sand (water, 1965')	1960	- 2090
Little Line	2072	- 2232
Merrill Cave	2232	- 2235
Big Line	2235	- 2365
Big Injun Sand (light show oil and water, 2438')	2365	- 2503
Fifty-foot Sand	2505	- 3030
Thirty-foot Sand (oil show, 3073'; oil, 3075')	3060	- 3084
Total depth		3095