

Latitude

Longitude



Topo Location

7.5' Loc. _____ 15' Loc. _____
 _____ (calc.) _____

Company Hope

Farm Ephraim Board #1


15' Quad _____
(sec.)

7.5' Quad Shumston

District Lincoln

WELL LOCATION PLAT

County 049 Permit 30345

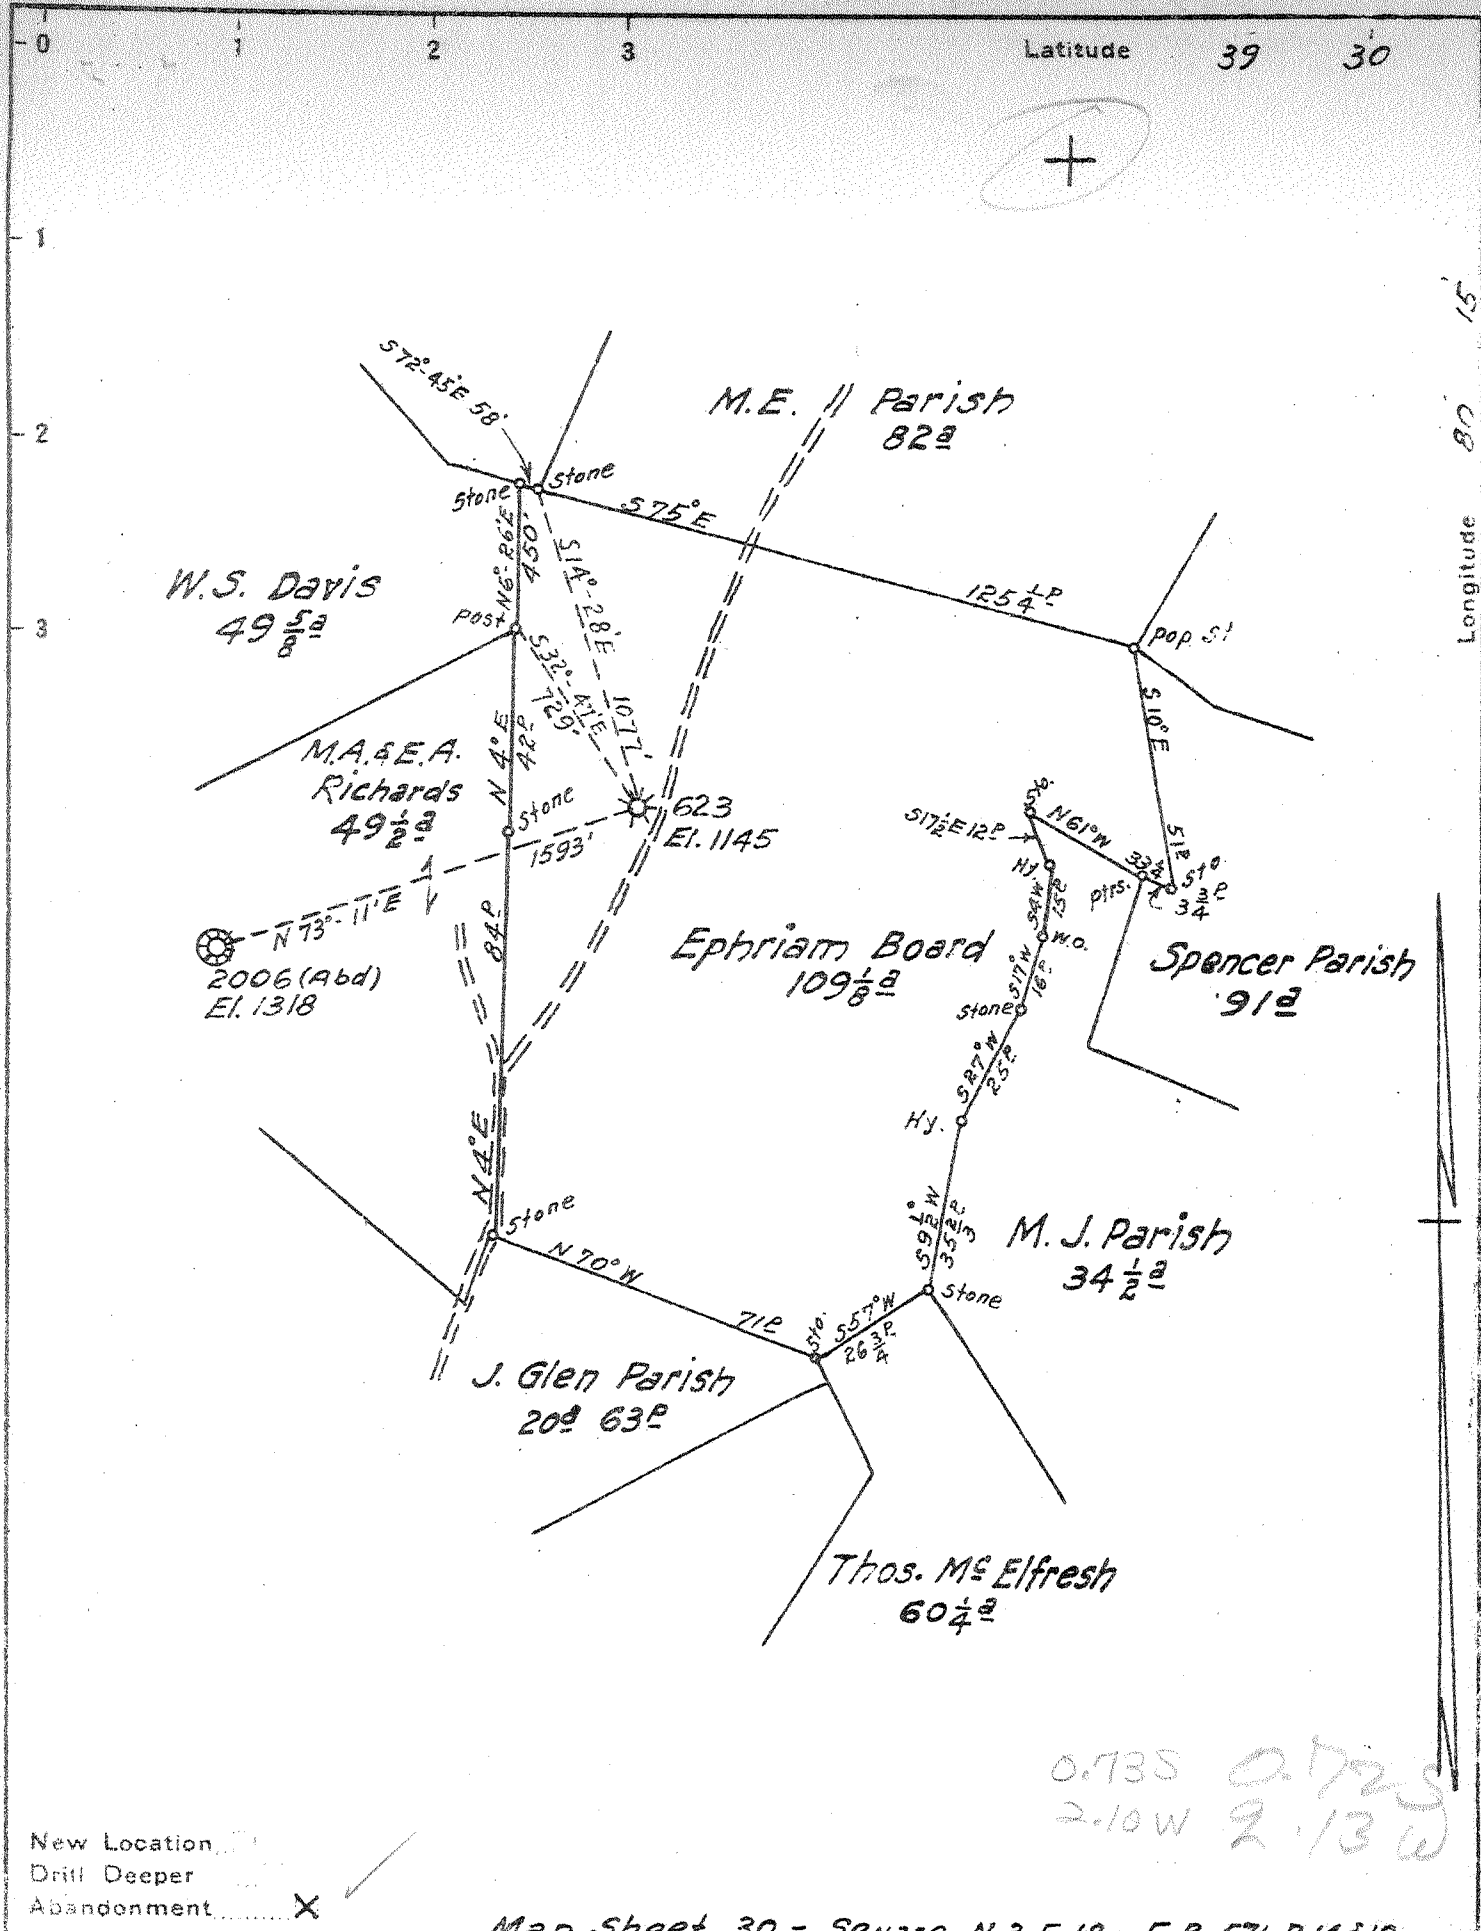

New Location
 Drill Deeper
 Abandonment

0.735 0.725
 2.10W 2.13W

Map Sheet 30 - Square N.3 E 18 - F.B. 571 P.14 & 19

Company Hope Natural Gas Co
 Address Clarksburg, W. Va.
 Farm Ephriam Board
 Fract. Acres 109 Lease No. 958
 Well (Farm) No. 1 Serial No. 623
 Elevation (Spirit Level) 1145
 Quadrangle Clarksburg
 County Marion District Lincoln
 Engineer Wm Powers
 Engineer's Registration No. 900
 File No. _____ Drawing No. _____
 Date April 6, 1942 Scale 1" = 40'

STATE OF WEST VIRGINIA
 DEPARTMENT OF MINES
 OIL AND GAS DIVISION
 CHARLESTON

WELL LOCATION MAP
 FILE NO. Mar-345-A

+ Denotes location of well on United States Topographic Maps, scale 1 to 62,500, latitude and longitude lines being represented by border lines as shown.
 - Denotes one inch spaces on border line of original tracing.