


Latitude

Longitude

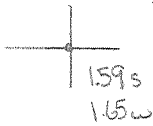

Topo Location

7.5' Loc. _____ 15' Loc. _____
 _____ (calc.) _____

Company _____

Farm _____


15' Quad _____
(sec.)

7.5' Quad Sherrington

District Mannington

WELL LOCATION PLAT

County 049 Permit 30400

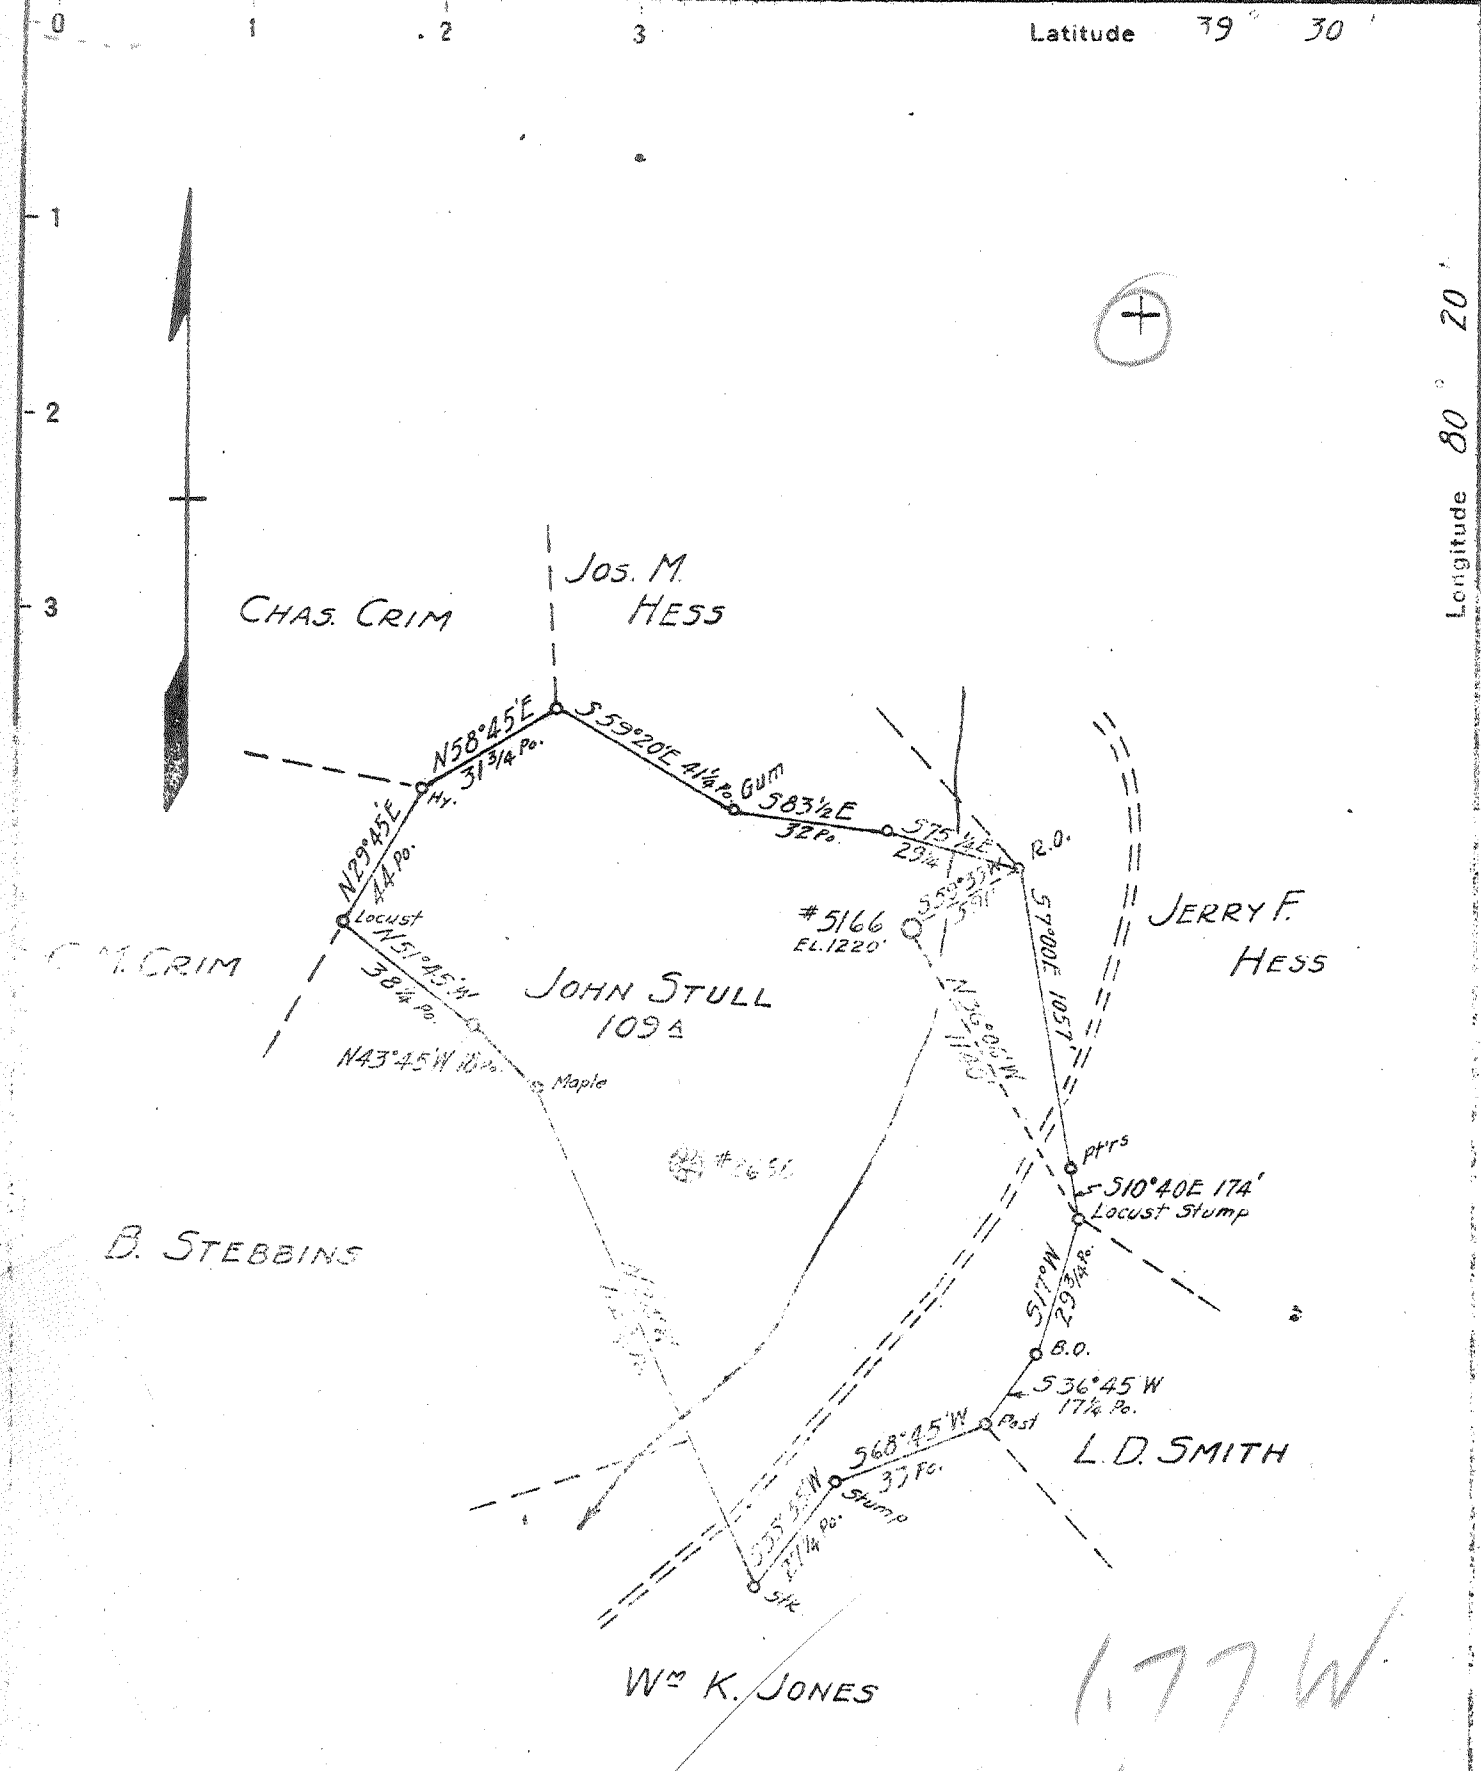

B. STEBBINS

1.77 W
1.69 A

JUL - 6 1944

Map Sh. 30. Sq. N-2 E-14 F.B. 591 P. 23

New Location

Drill Deeper

Abandonment (5166)

Company Hope Natural Gas Co.

Address Clarksburg W. Va.

Farm John Stull

Tract _____ Acres 109 Lease No. 3620

Well (Farm) No. _____ Serial No. 5166

Elevation (Spirit Level) 1220'

Quadrangle Clarksburg

County Marion District Mannington

Engineer W.M. Bowser

Engineer's Registration No. 900

File No. _____ Drawing No. _____

Date 6-16-44 Scale 1" = 40 Po.

STATE OF WEST VIRGINIA
DEPARTMENT OF MINES
OIL AND GAS DIVISION
CHARLESTON

WELL LOCATION MAP
FILE NO. MAR-400-A

+ Denotes location of well on United States Topographic Maps, scale 1 to 62,500, latitude and longitude lines being represented by border lines as shown.

- Denotes one inch spaces on border line of original tracing.

INSURANCE TRACING CLOTH