


LATITUDE 39 35

LONGITUDE 80 17 30

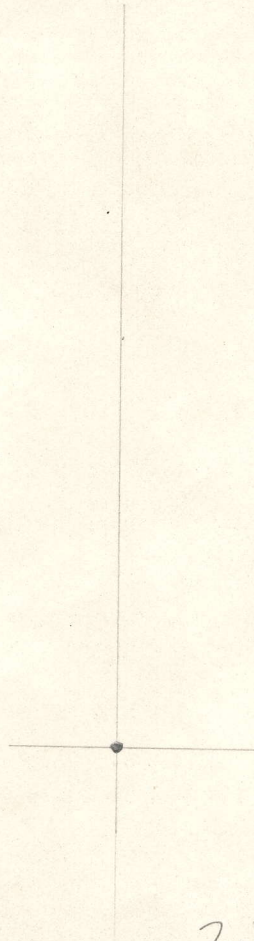

2.85
2.22W

7'5 OGIS topo location

7.5' loc _____	15' loc _____
_____	(calc.) _____

Company _____

Farm JOHN BLACKSHERE

Quad MANNINGTON

County MARION

District MANNINGTON

WELL LOCATION MAP

File No. 30457

Latitude 39 35

Longitude 80 15



New Location
 Drill Deeper
 Abandonment **6756**

Map Sh. 26 Sp. N-7 E-17 P.D. 778 R13-6418

Company HOPE NATURAL GAS CO.
 Address CLARKSBURG, W. VA.
 Farm JOHN BLACKSHERE

STATE OF WEST VIRGINIA
 DEPARTMENT OF MINES
 OIL AND GAS DIVISION
 CHARLESTON

Permit No. 7111 1017 WELL RECORD Oil or Gas Well (1903)

Company HOPS NATURAL GAS COMPANY

Address 645 West Main St. Clarkburg, W. Va.

Farm John Blackshara Acres 335

Location (waters) _____

Well No. 6736 Elev. 1274

District Mannington County Marion

The surface of tract is owned in fee by _____

Address _____

Mineral rights are owned by _____

Address _____

Drilling commenced March 18, 1903

Drilling completed April 23, 1903

Date Shot _____ From _____ To _____

With _____

Open Flow /10ths Water in _____ Inch

/10ths Merc. in _____ Inch

Volume _____ Cu. Ft.

Rock Pressure _____ lbs. _____ hrs.

Oil _____ bbls., 1st 24 hrs.

Fresh water none recorded feet _____ feet

Salt water none recorded feet _____ feet

Casing and Tubing	Used in Drilling	Left in Well	Packers
Size			
16			Kind of Packer _____
12			
10	255	Pulled	Size of _____
8 1/2	1500	Pulled	
6 1/2	1712	1712	Depth set _____
5 3/16	2024	2024	
2			Perf. top _____
2	3001	Pulled	Perf. bottom _____
Liners Used			Perf. top _____
4 1/2"	830	Pulled	Perf. bottom _____


CASING CEMENTED NOT SIZE _____ No. Ft. _____ Date _____

COAL WAS ENCOUNTERED AT 729 FEET ? INCHES

FEET _____ INCHES _____ FEET _____ INCHES

FEET _____ INCHES _____ FEET _____ INCHES

Formation	Color	Hard or Soft	Top	Bottom	Oil, Gas or Water	Depth Found	Remarks
Pittsburgh	Coal		729	?			
Gas sand			1430	1510			
First Salt			1645	1700			
Big Lime			2005	2060			
Big Injun			2060	2190	oil	2148	
Squaw			2198	2230			
Sents			2580	2580			
Fifty foot			2660	2710	gas	2664 69	
Sand			2820	2850			
Gordon stray			2897	2932			
Gordon			2953	2974			
Fourth			2980		gas	2992 2997	
Total depth				3001			

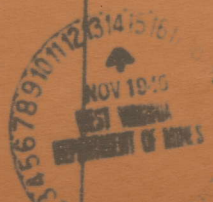

AFFIDAVIT SHOULD BE MADE IN TRIPPLICATE. ONE COPY MAILED TO THE DEPARTMENT. ONE COPY TO BE RETAINED BY THE WELL OPERATOR AND THE THIRD COPY (AND EXTRA COPIES IF REQUIRED) SHOULD BE MAILED TO EACH COAL OPERATOR AT THEIR RESPECTIVE ADDRESSES.

No coal operations
COAL OPERATOR OR OWNER
ADDRESS

Hope Natural Gas Company.
NAME OF WELL OPERATOR
445 West Main St. Clarksburg, W. Va.
COMPLETE ADDRESS

COAL OPERATOR OR OWNER
ADDRESS

WELL AND LOCATION
194
Mannington, District
Marion, County
Well No. 6756
John Blackshere, Farm

STATE INSPECTOR SUPERVISING PLUGGING

AFFIDAVIT

STATE OF WEST VIRGINIA,
County of Marion } ss:

Roy B. Kennedy and Robert A. Kennedy
being first duly sworn according to law depose and say that they are experienced in the work of plugging and filling oil and gas wells and were employed by Hope Natural Gas Company, well operator, and participated in the work of plugging and filling the above well, that said work was commenced on the 15th day of November, 1946, and that the well was plugged and filled in the following manner:

SAND OR ZONE RECORD	FILLING MATERIAL			PLUGS USED	CASING	
	FORMATION	CONTENT	FROM TO		SIZE & KIND	COG PULLED
Pittsburgh Coal 725	Clay	327	Surface		6-5/8	
Gas Sand 1450-1510	Cement	337	327		338	1374
Salt Sand 1645-1700	Clay	700	337			
Big Lime 2005-2060	Cement	779	700			
Big Injun 2060-2120	Clay	800	779			
Squaw 2193-2230	Bridged at 800					
Genta 2330-2350	Cement	1680	1610		4-1/2 x 4	
Fifty Foot 2360-2710	Clay	1716	1680		831	
Sand 2320-2350	Cement	1722	1716			
Gordon Stray 2327-2332	Clay	1722	1722			
Gordon 2332-2374	Bridged at 1722					
Total Depth 3001	Cement	2040	2020			
	Clay	2220	2040			
	Bridged at 2220					
	Cement	2640	2630			
COAL BEAMS	Clay	2740	2640			
(NAME)	Bridged at 2740					
(NAME)	Cement	2960	2950			
(NAME)	Clay	3001	2960			
(NAME)						

and that the work of plugging and filling said well was completed on the 27th day of December, 1946.

And further deponents saith not.

Sworn to and subscribed

before me this 17 day of January, 1947.

Roy B. Kennedy
Robert A. Kennedy
Notary Public

My commission expires

Notary Public

157