


Scale, 1" = 200'

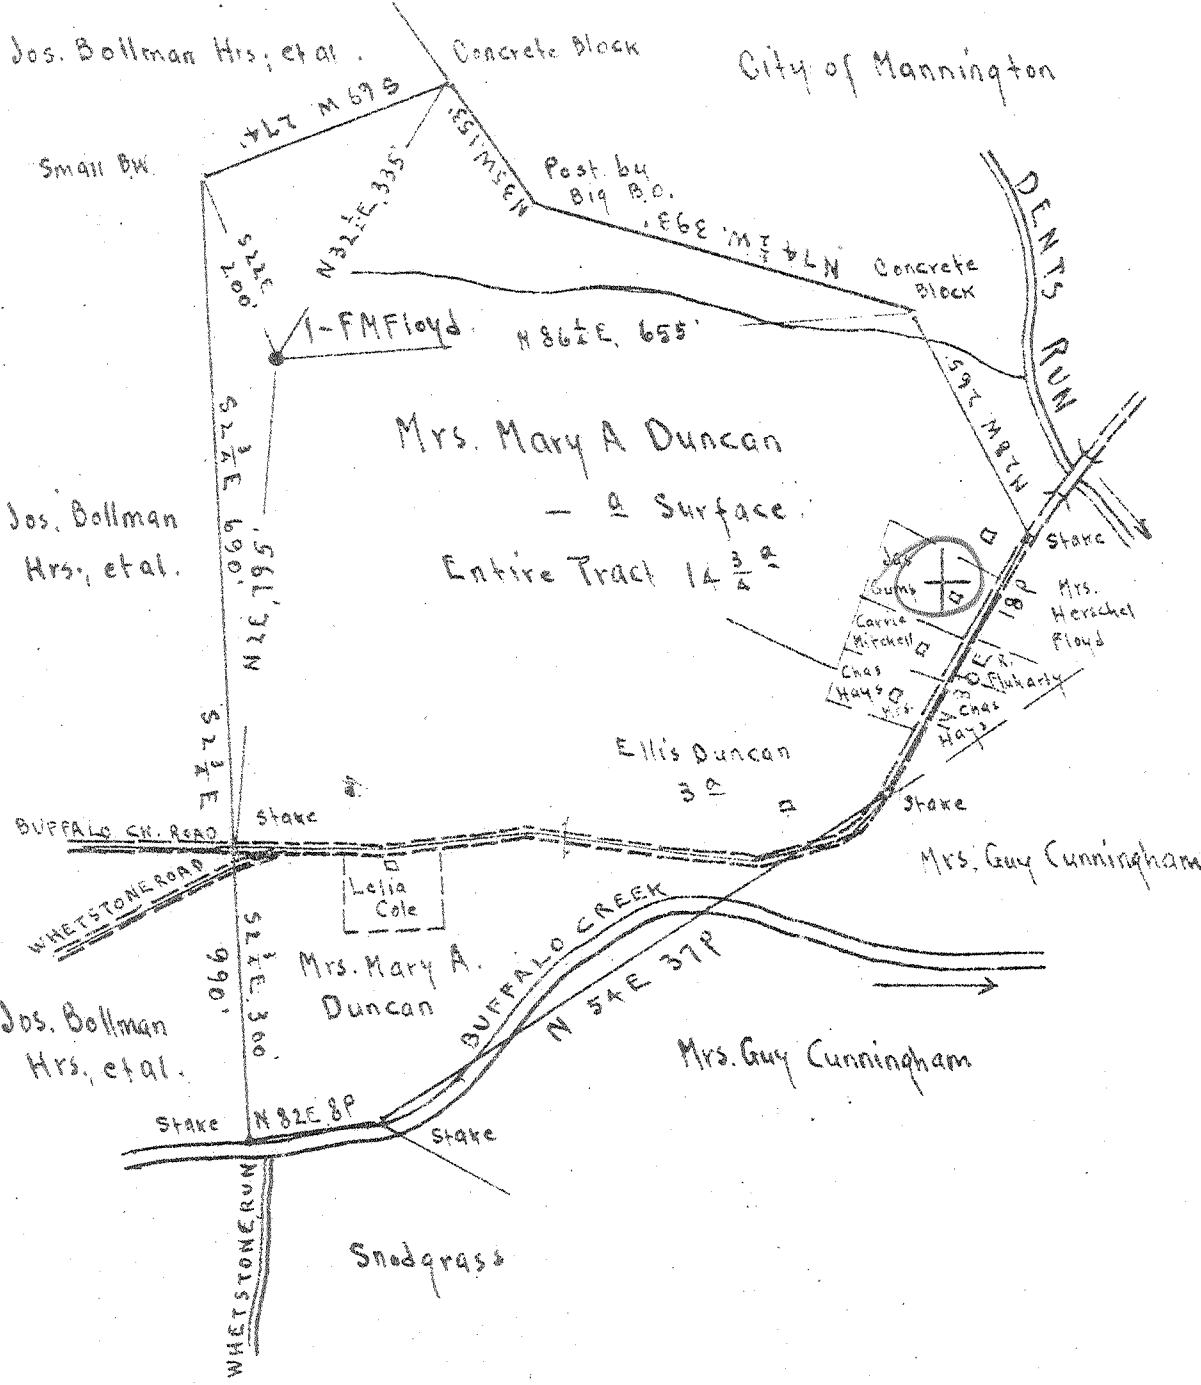

Surface: Mrs. Mary A. Duncan. RFD # 1, Mannington, W.Va.

Coal: Mr. Harry Shaw, 425 Morgantown Ave. Fairmont, W.Va.

- New Location
- Drill Deeper
- Abandonment

FEB - 3 1947

Map 2857. N 5 E 14 4.0

Company The Interstate Pipe and Supply Co.
 Address Marietta Ohio.
 Farm F.M. Floyd
 Tract Acres 14 3/4 Lease No. _____
 Well (Farm) No. 1 Serial No. _____
 Elevation (Spirit Level) Floor 1177.33
 Ground 1175.83
 Quadrangle Mannington
 County Marion District Mannington
 Engineer E.C. Tabler
 Engineer's Registration No. _____
 File No. _____ Drawing No. _____
 Date Oct 29th 1946 Scale 1" = 200'

1947
 STATE OF WEST VIRGINIA
 DEPARTMENT OF MINES
 OIL AND GAS DIVISION
 CHARLESTON

WELL LOCATION MAP
 FILE NO. MAR-461-A

+ Denotes location of well on United States Topographic Maps, scale 1 to 62,500, latitude and longitude lines being represented by border lines as shown.
 - Denotes one inch spaces on border line of original tracing.



537

STATE OF WEST VIRGINIA
DEPARTMENT OF MINES
OIL AND GAS DIVISION

WELL RECORD

Permit No. Y61-A

Oil or Gas Well Oil
(KIND)

Company The Interstate Pipe & Supply Company
Address Box 611, Marietta, Ohio
Farm F. M. Floyd Acres 1/4
Location (waters) _____
Well No. 1 Elev. 1175.83
District Marion County Marion
The surface of tract is owned in fee by Mrs. Mary A. Dungan
R. F. D. 1 Address Marion, W. Va.
Mineral rights are owned by Harry Shaw
125 Morgantown Ave. Address Fairmont, W. Va.

Casing and Tubing	Used in Drilling	Left in Well	Packers
Size			Kind of Packer
16			
13			
10	435	435	Size of
8 1/4	1170	1170	
6 5/8	2649	2649	Depth set <u>2629</u>
5 3/16	2368	2368	
3			Perf. top
2			Perf. bottom
Liners Used			Perf. top
<u>4 1/2 x 4</u>	208	208	Perf. bottom
<u>4 1/2 x 4</u>	245'	245'	

Drilling commenced _____
Drilling completed _____
Date Shot _____ From 2908 To _____
With _____
Open Flow _____ /10ths Water in _____ Inch
_____ /10ths Merc. in _____ Inch
Volume _____ Cu. Ft.
Rock Pressure _____ lbs. _____ hrs.
Oil _____ bbls., 1st 24 hrs.
Fresh water _____ feet _____ feet
Salt water _____ feet _____ feet

CASING CEMENTED _____ SIZE _____ No. Ft. _____ Date _____
COAL WAS ENCOUNTERED AT 610 FEET 60 INCHES
690 FEET 120 INCHES FEET INCHES
FEET INCHES FEET INCHES

Formation	Color	Hard or Soft	Top	Bottom	Oil, Gas or Water	Depth Found	Remarks
Conductor				12			
Mapletown Coal			610	615			
Pittsburgh Coal			690	700			
Dunkard Sand			1230	1300			
Gas Sand			1360	1459			
Salt Sand			1590	1695			
Big lime			1960	2045			
Pencil Cave			1950	1960			
Big Injan			2045	2180	Water	2135	
Canta Sand			2590	2600			
Fifty Foot			2640	2690	Gas	2650	
Gordon Sand			2907	2935			
1st pay			2910				
2nd pay			2914				
Total Depth				2935			
<p>245' of 4-1/4 x 4 liner with packer on top. Packer set at 2657.</p> <p>10/25/26 put in 208' of 4 1/2 x 4 liner (11 jts.) with packer set (on Bottom) at 2629', 3' above lower section.</p>							

