

New Location   
 Drill Deeper   
 Abandonment  PARTIAL

JUL 28 1947

Company Pittsburgh & W.Va. Gas Co.  
 Address Clarksburg, W.Va.  
 Farm L. W. SHROYER  
 Tract \_\_\_\_\_ Acres 45 Lease No. 14597  
 Well (Farm) No. 1 Serial No. 5168  
 Elevation (Spirit Level) 1320' V.A.  
 Quadrangle Fairmont N.W. 12  
 County Marion District Fairmont  
 Engineer Kenneth B. Moore  
 Engineer's Registration No. \_\_\_\_\_  
 File No. DV-31.P-103 Drawing No. \_\_\_\_\_  
 Date July 15, 1947 Scale 1" = 300'

STATE OF WEST VIRGINIA  
 DEPARTMENT OF MINES  
 OIL AND GAS DIVISION  
 CHARLESTON

WELL LOCATION MAP  
 FILE NO. MAR-473-A

+ Denotes location of well on United States Topographic Maps, scale 1 to 62,500, latitude and longitude lines being represented by border lines as shown.

- Denotes one inch spaces on border line of original tracing.

AL

L.W. SHROYER No 1 (5168) - PG 48 W.VA GAS CO MAR 473-A

FORM 650-1023

Record of Well No. 5768 Located on L. W. Shinger Farm April 5 1916  
Parrusut District Marion County West Va State  
 Division R District No. \_\_\_\_\_ Drilled under well Order 502  
 Rig built by John Craig Began May 5 1916 Completed May 10 1916  
 Well drilled by Mark Hartness Began July 6 1916 Completed Aug 11 1916  
 Depth of Well 3030 feet Size of Hole 5 3/16 Producing Gas  
2160 to 2980 Elev 1320 GL.

| CASED WITH       |                   |                 | REMARKS                                |
|------------------|-------------------|-----------------|--|
| AMOUNT           | SIZE              | KIND            |  |
| 16'              | 16"               | wood            |  |
| 638'             | 10"               | haul            | Connected                              |
| <del>1570'</del> | <del>8 1/2"</del> | <del>haul</del> | <del>8 1/4 casing shoe Reclaimed</del> |
| 1907'            | 6 5/8"            | "               | 8 1/4 x 6 5/8 B.H. Caster              |
| 2802'            | 5 3/16"           | "               | 1-5 3/16 Aug. shoe                     |
| <del>3058'</del> | <del>2"</del>     | <del>haul</del> |  |

COAL VEINS Mapleton 464 ft. 578

| FORMATIONS                  |       |                            |      |        |  |
|-----------------------------|-------|----------------------------|------|--------|--|
| FORMATION                   | COLOR | OPEN OR CLOSE HARD OR SOFT | TOP  | BOTTOM | REMARKS GAS-OIL-WATER (THICKNESS OF PAY) |
| <del>Little Sand</del>      |       |                            | 950  | 985    | <del>Water 1580-1582</del>               |
| <del>Big "</del>            |       |                            | 1090 | 1140   |  |
| <del>Gas Sand</del>         |       |                            | 1340 | 1390   |  |
| <del>W. Hill Sand</del>     |       |                            | 1415 | 1460   |  |
| <del>and "</del>            |       |                            | 1495 |        | Water 1580-1582                          |
| <del>Sand</del>             |       |                            | 1650 | 1690   |  |
| <del>Little Limestone</del> |       |                            | 1805 | 1862   |  |
| <del>Big Limestone</del>    |       |                            | 1871 | 1942   |  |
| <del>W. Hill Sand</del>     |       |                            | 2010 | 2480   | Gas 1480. 5W2. 94 mcf                    |
| <del>Shale</del>            |       |                            | 2488 | 2590   |  |
| <del>W. Hill Sand</del>     |       |                            | 2757 | 2800   |  |
| <del>Gas Sand</del>         |       |                            |      | 2848   |  |
| <del>W. Hill Sand</del>     |       |                            | 2928 | 2971   | " 2952-2957. 5W2. 94 mcf                 |
| <del>Shale</del>            |       |                            |      | 3030   |  |

(064) Farmington





506

STATE OF WEST VIRGINIA  
DEPARTMENT OF MINES  
OIL AND GAS DIVISION

WELL RECORD

Permit No. 413-A Oil or Gas Well Gas  
(KIND)


Company Pittsburgh E. W. Va. Gas Co.  
Address Clarksburg, W. Va.  
Farm L. W. Shroyer Acres 45  
Location (waters) Fairmont N.W. 1/2  
Well No. 516B Elev. 1320' VA.  
District Fairmont County Marion  
The surface of tract is owned in fee by Mrs. L. W. Shroyer  
407 Murray Ave. Address Fairmont, W. Va.  
Mineral rights are owned by Anne E. Shroyer & T. M. Shroyer et al  
Address 407 Murray Ave. Fairmont, W. Va.  
Drilling commenced 7-6-16  
Drilling completed 9-11-16  
Date Shot 9-13-16 From \_\_\_\_\_ To 2971'  
With \_\_\_\_\_

| Casing and Tubing | Used in Drilling | Left in Well | Packers                        |
|-------------------|------------------|--------------|--------------------------------|
| Size              |                  |              |                                |
| 16                | 16'              | 16'          | Kind of Packer <u>B.H.</u>     |
| 13                |                  |              |                                |
| 10                | 638'             | 638' Cement  | Size of <u>8 1/4" x 6 5/8"</u> |
| 8 1/4             | 1575'            | Pulled       |                                |
| 6 3/8             | 1907'            | 1907'        | Depth set <u>1907'</u>         |
| 5 3/16            | 2802'            | 2802'        |                                |
| 3                 |                  |              | Perf. top _____                |
| 2                 |                  |              | Perf. bottom _____             |
| Liners Used       |                  |              | Perf. top _____                |
|                   |                  |              | Perf. bottom _____             |

Open Flow \_\_\_\_\_ /10ths Water in \_\_\_\_\_ Inch  
\_\_\_\_\_ /10ths Merc. in \_\_\_\_\_ Inch  
Volume \_\_\_\_\_ Cu. Ft.  
Rock Pressure \_\_\_\_\_ lbs. \_\_\_\_\_ hrs.  
Oil \_\_\_\_\_ bbls., 1st 24 hrs.  
Fresh water \_\_\_\_\_ feet \_\_\_\_\_ feet  
Salt water \_\_\_\_\_ feet \_\_\_\_\_ feet

CASING CEMENTED \_\_\_\_\_ SIZE \_\_\_\_\_ No. Ft. \_\_\_\_\_ Date \_\_\_\_\_  
COAL WAS ENCOUNTERED AT 458' To 464' Mapletown FEET INCHES  
570' To 578' Pittsburgh FEET INCHES FEET INCHES  
FEET INCHES FEET INCHES  
FEET INCHES FEET INCHES

| Formation        | Color | Hard or Soft | Top  | Bottom | Oil, Gas or Water | Depth Found | Remarks    |
|------------------|-------|--------------|------|--------|-------------------|-------------|------------|
| Mapletown (Coal) |       |              | 458  | 464    |                   |             |            |
| Ogh. Coal        |       |              | 570  | 578    |                   |             |            |
| L. Dunkard       |       |              | 950  | 985    |                   |             |            |
| B. Dunkard       |       |              | 1090 | 1140   |                   |             |            |
| Gas Sand         |       |              | 1340 | 1390   |                   |             |            |
| 1st Salt Sd.     |       |              | 1415 | 1450   |                   |             |            |
| 2nd Salt Sd.     |       |              | 1495 |        | Water             | 1532'-62'   |            |
| Sand             |       |              | 1650 | 1690   |                   |             |            |
| L. Lime          |       |              | 1855 | 1862   |                   |             |            |
| B. Lime          |       |              | 1871 | 1942   |                   |             |            |
| B. Injun         |       |              | 1942 | 2030   | Gas               | 1982'       | 5/16" W-2" |
| 50 Ft. Sd.       |       |              | 2410 | 2480   |                   |             |            |
| 30 Ft. Sd.       |       |              | 2488 | 2590   |                   |             |            |
| Gordon Stray     |       |              | 2757 | 2800   |                   |             |            |
| Gordon           |       |              |      | 2848   |                   |             | No Break   |
| 4th Sand         |       |              | 2866 | 2885   |                   |             |            |
| 5th Sand         |       |              | 2938 | 2971   | Gas               | 2952'-57'   | 5/16" W-2" |
| Slate            |       |              | 2971 | 3030   |                   |             |            |
| Total Depth      |       |              |      | 3030'  |                   |             |            |

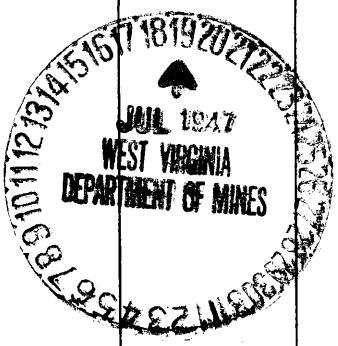

Handwritten mark resembling a stylized 'C' or '9'.

Pittsburgh + W. Va. Gas Co  
J. B. Snyder

(Over)

7-18-47