

Surface: Jas. P. & Anna Hafer.
 Address Jas P. Hafer, P.O. Box 105, Mannington, W. Va.

Coal: Same as above, Jas P. & Anna Hafer.

New Location
 Drill Deeper
 Abandonment

APR 14 1948
 On 400' maps 2757 & 2758 N 6 E 15-16

Company Road Supply Co.
 Address Salem, W. Va.
 Farm Kate Hafer
 Tract Acres 1 1/2 Lease No. _____
 Well (Farm) No. 1 Serial No. _____
 Elevation (Spirit Level) Floor = 978.83
excavated = 977.53
 Quadrangle MANNINGTON
 County Marion District Mannington
 Engineer E. C. Tabler
 Engineer's Registration No. _____
 File No. _____ Drawing No. _____
 Date March 19th 1948 Scale 1" = 100 Feet

STATE OF WEST VIRGINIA
 DEPARTMENT OF MINES
 OIL AND GAS DIVISION
 CHARLESTON

WELL LOCATION MAP
 FILE NO. MAR-504-A

+ Denotes location of well on United States Topographic Maps, scale 1 to 62,500, latitude and longitude lines being represented by border lines as shown.
 - Denotes one inch spaces on border line of original tracing.



576

STATE OF WEST VIRGINIA
DEPARTMENT OF MINES
OIL AND GAS DIVISION

WELL RECORD

Permit No. 507-A

Oil or Gas Well (KIND)


Company RAAD SUPPLY COMPANY
Address 184 E. Main St., Salem, W. Va.
Farm Kate Hafer Acres 1 1/4
Location (waters) Pyles Fork of Buffalo Creek
Well No. 1 Elev. 977.53
District Mannington County Marion
The surface of tract is owned in fee by Jas. P. & Ann Hafer, Box 105 Address Mannington W. Va.
Mineral rights are owned by Same as Surface.

Casing and Tubing	Used in Drilling	Left in Well	Packers
Size			Kind of Packer
16			
13			
10	386'	386'	Size of
8 1/4	1020'	1020'	
6 5/8	1539'	1539'	Depth set
5 3/16	1965'	1965'	
3			Perf. top
2	2710'	2710'	Perf. bottom
Liners Used			Perf. top
			Perf. bottom

Drilling commenced
Drilling completed March 22, 1897
Date Shot From To
With
Open Flow /10ths Water in Inch
/10ths Merc. in Inch
Volume Cu. Ft.
Rock Pressure lbs. hrs.
Oil bbls., 1st 24 hrs.
Fresh water feet feet
Salt water feet feet

CASING CEMENTED SIZE No. Ft. Date
COAL WAS ENCOUNTERED AT 2 FEET INCHES
FEET INCHES FEET INCHES
FEET INCHES FEET INCHES

Formation	Color	Hard or Soft	Top	Bottom	Oil, Gas or Water	Depth Found	Remarks
Conductor				23			
Pittsburgh Coal			464	472			
1st. Pay			2683				
2nd Pay			2687				
Total Depth				2710			
RECORD INCOMPLETE - Producing Sand - Gordon.							

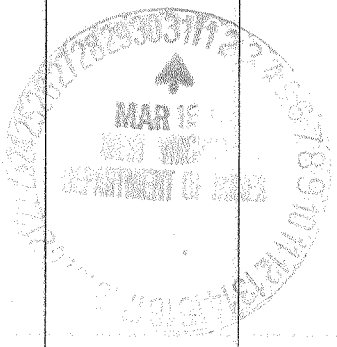

Formation	Color	Hard or Soft	Top	Bottom	Oil, Gas or Water	Depth Found	Remarks

Date March 30, 194

APPROVED RAAD SUPPLY COMPANY, Owner

By J. M. RAAD, OWNER

(Title)

J. M. Raad