


Scale 1" = 800 Feet

Longitude 80 20

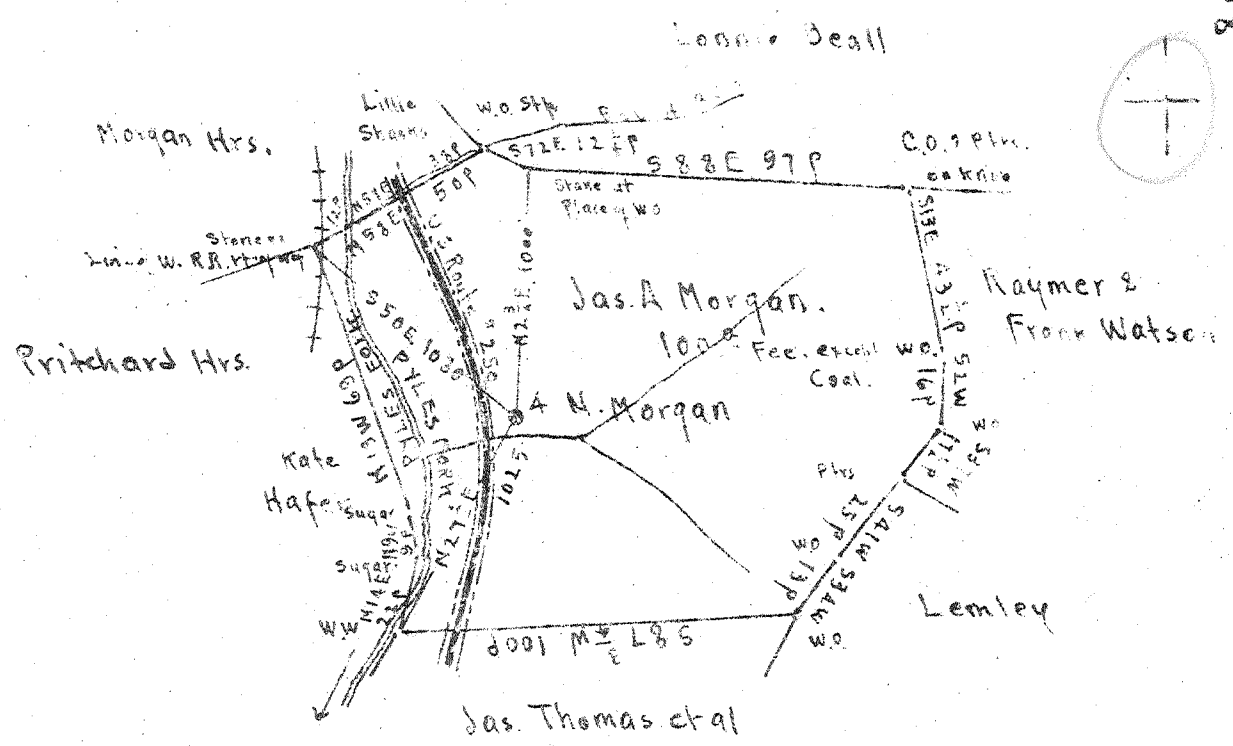

Surface: Jas. A. Morgan, Mannington, W.Va.
 Coal - Jamison Coal & Coke Co.
 Jamison Bldg, Greensburg, Pa.

2695
 0.5W
 APR 14 1948
 2722

New Location
 Drill Deeper
 Abandonment On 400 maps 2757 & 2758. N 6-7 E 16

Company Road Supply Co.
 Address Salem, W.Va.
 Farm Nimrod Morgan
 Tract Acres 100 Lease No. _____
 Well (Farm) No. A Serial No. _____
 Elevation (Spirit Level) Floor - 1057.41
Ground - 1045.61
 Quadrangle MANNINGTON
 County Marion District Mannington
 Engineer E C Tabler
 Engineer's Registration No. _____
 File No. _____ Drawing No. _____
 Date March 19th 1948 Scale 1" = 800 Feet

STATE OF WEST VIRGINIA
 DEPARTMENT OF MINES
 OIL AND GAS DIVISION
 CHARLESTON

WELL LOCATION MAP
 FILE NO. MAR-505-A

+ Denotes location of well on United States Topographic Maps, scale 1 to 62,500, latitude and longitude lines being represented by border lines as shown.
 - Denotes one inch spaces on border line of original tracing.



662

STATE OF WEST VIRGINIA
DEPARTMENT OF MINES
OIL AND GAS DIVISION

WELL RECORD

Permit No. 505-A

Oil or Gas Well
(KIND)

Company RAAD SUPPLY COMPANY
Address 184 E. Main St., Salem, W. Va.
Farm Nimrod Morgan Acres 100
Location (waters) Pyles Fork of Buffalo Creek
Well No. 4 Elev. 1045.61
District Mannington County Marion
The surface of tract is owned in fee by Jas. A. Morgan
Address Mannington, W. Va.
Mineral rights are owned by Jamison Coal & Coke Co.
Jamison Building Address Greensburg, Pa.
Drilling commenced.....
Drilling completed September 9, 1897
Date Shot From To
With

Casing and Tubing	Used in Drilling	Left in Well	Packers
Size			
16			Kind of Packer
13			
10			Size of
8 1/4			
6 3/4	1813'	1813'	Depth set
5 3/16	2150'	2150'	
3			Perf. top
2	2776'	2776'	Perf. bottom
Liners Used			Perf. top
			Perf. bottom

Open Flow /10ths Water in..... Inch
/10ths Merc. in..... Inch
Volume..... Cu. Ft.
Rock Pressure..... lbs..... hrs.
Oil..... bbls., 1st 24 hrs.
Fresh water..... feet..... feet
Salt water..... feet..... feet

CASING CEMENTED..... SIZE..... No. Ft..... Date
COAL WAS ENCOUNTERED AT..... FEET..... INCHES
..... FEET..... INCHES..... FEET..... INCHES
..... FEET..... INCHES..... FEET..... INCHES

Formation	Color	Hard or Soft	Top	Bottom	Oil, Gas or Water	Depth Found	Remarks
Conductor							
Pittsburgh Coal			532				
Gordon Sand			2749				
1st Pay.			2752				
Total Depth				2776'			
RECORD INCOMPLETE - Producing Sand - Gordon.							



