


Scale: 1" = 400 Feet

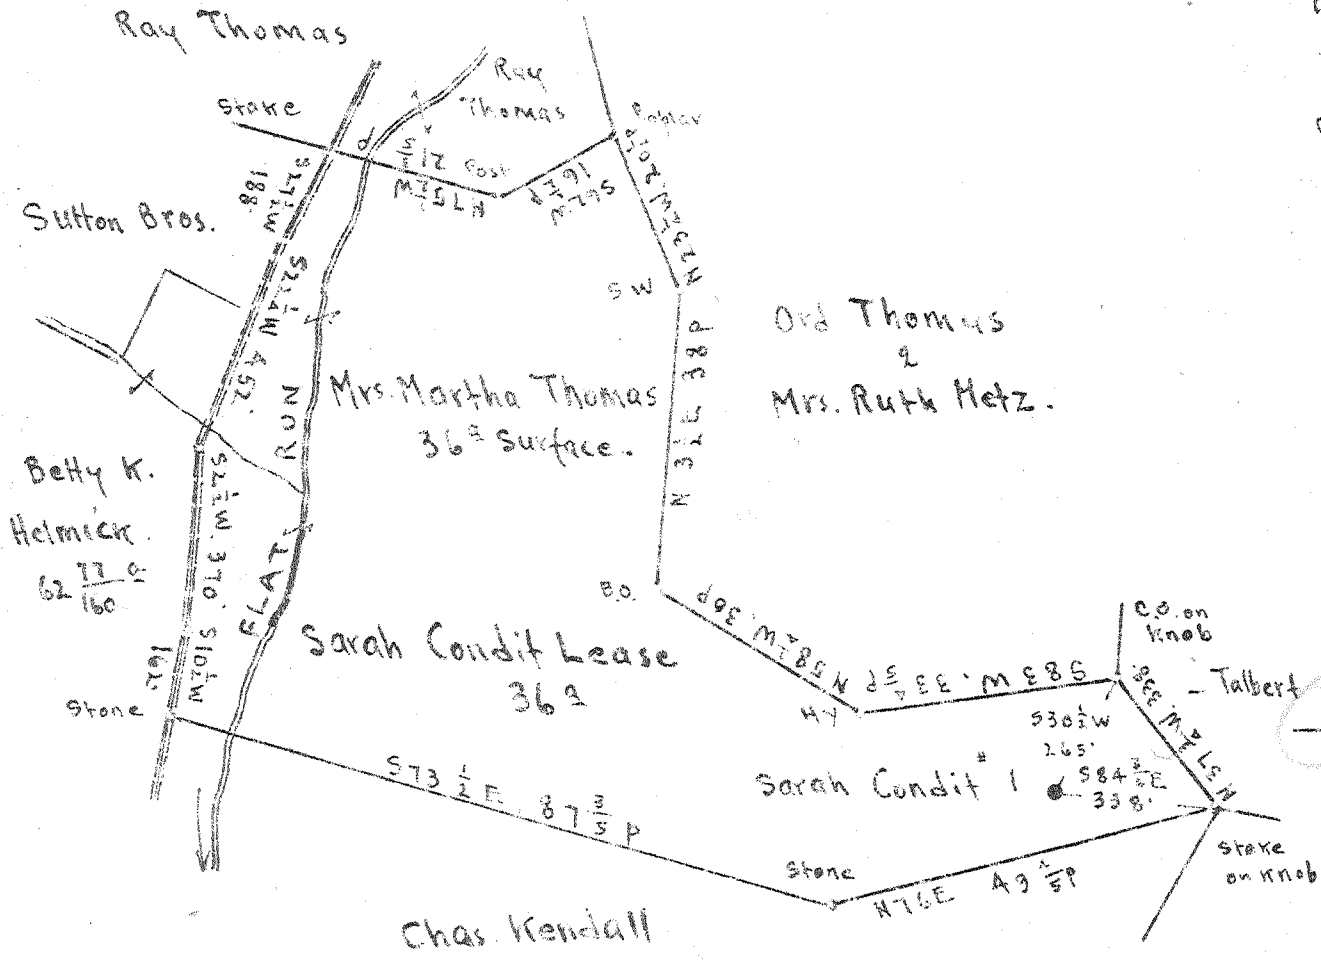

5.50 S
0.20 W

Surface: Mrs. Martha Thomas; AFD # 3, Mannington, W.Va.
Coal: Wheeling Dollar Savings & Trust Co., Wheeling W.Va.

New Location
Drill Deeper
Abandonment On 400' map # 2558.

JUN 15 1948

N 10 E 16

Company The Tri-State Pipe Co.
 Address Bellaire Ohio.
 Farm Sarah Condit
 Tract Acres 36 Lease No. _____
 Well (Farm) No. 1 Serial No. _____
 Elevation (Spirit Level) Floor 1273.35
 Ground 1271.35
 Quadrangle MANNINGTON
 County Marion District Mannington
 Engineer E.C. Tabler
 Engineer's Registration No. _____
 File No. _____ Drawing No. _____
 Date March 25th 1948 Scale 1" = 400 Feet

STATE OF WEST VIRGINIA
DEPARTMENT OF MINES
OIL AND GAS DIVISION
CHARLESTON

WELL LOCATION MAP
FILE NO. MAR-520-A

+ Denotes location of well on United States Topographic Maps, scale 1 to 62,500, latitude and longitude lines being represented by border lines as shown.

- Denotes one inch spaces on border line of original tracing.

