

39°37'30"

Latitude

80°15'00"

Longitude

2.03s
.37w

Topo Location

7.5' Loc. _____ 15' Loc. _____
_____ (calc.) _____

Company _____

Farm _____


15' Quad _____
(sec.)

7.5' Quad Mammington

District Paw Paw

WELL LOCATION PLAT

County 049 Permit 30523

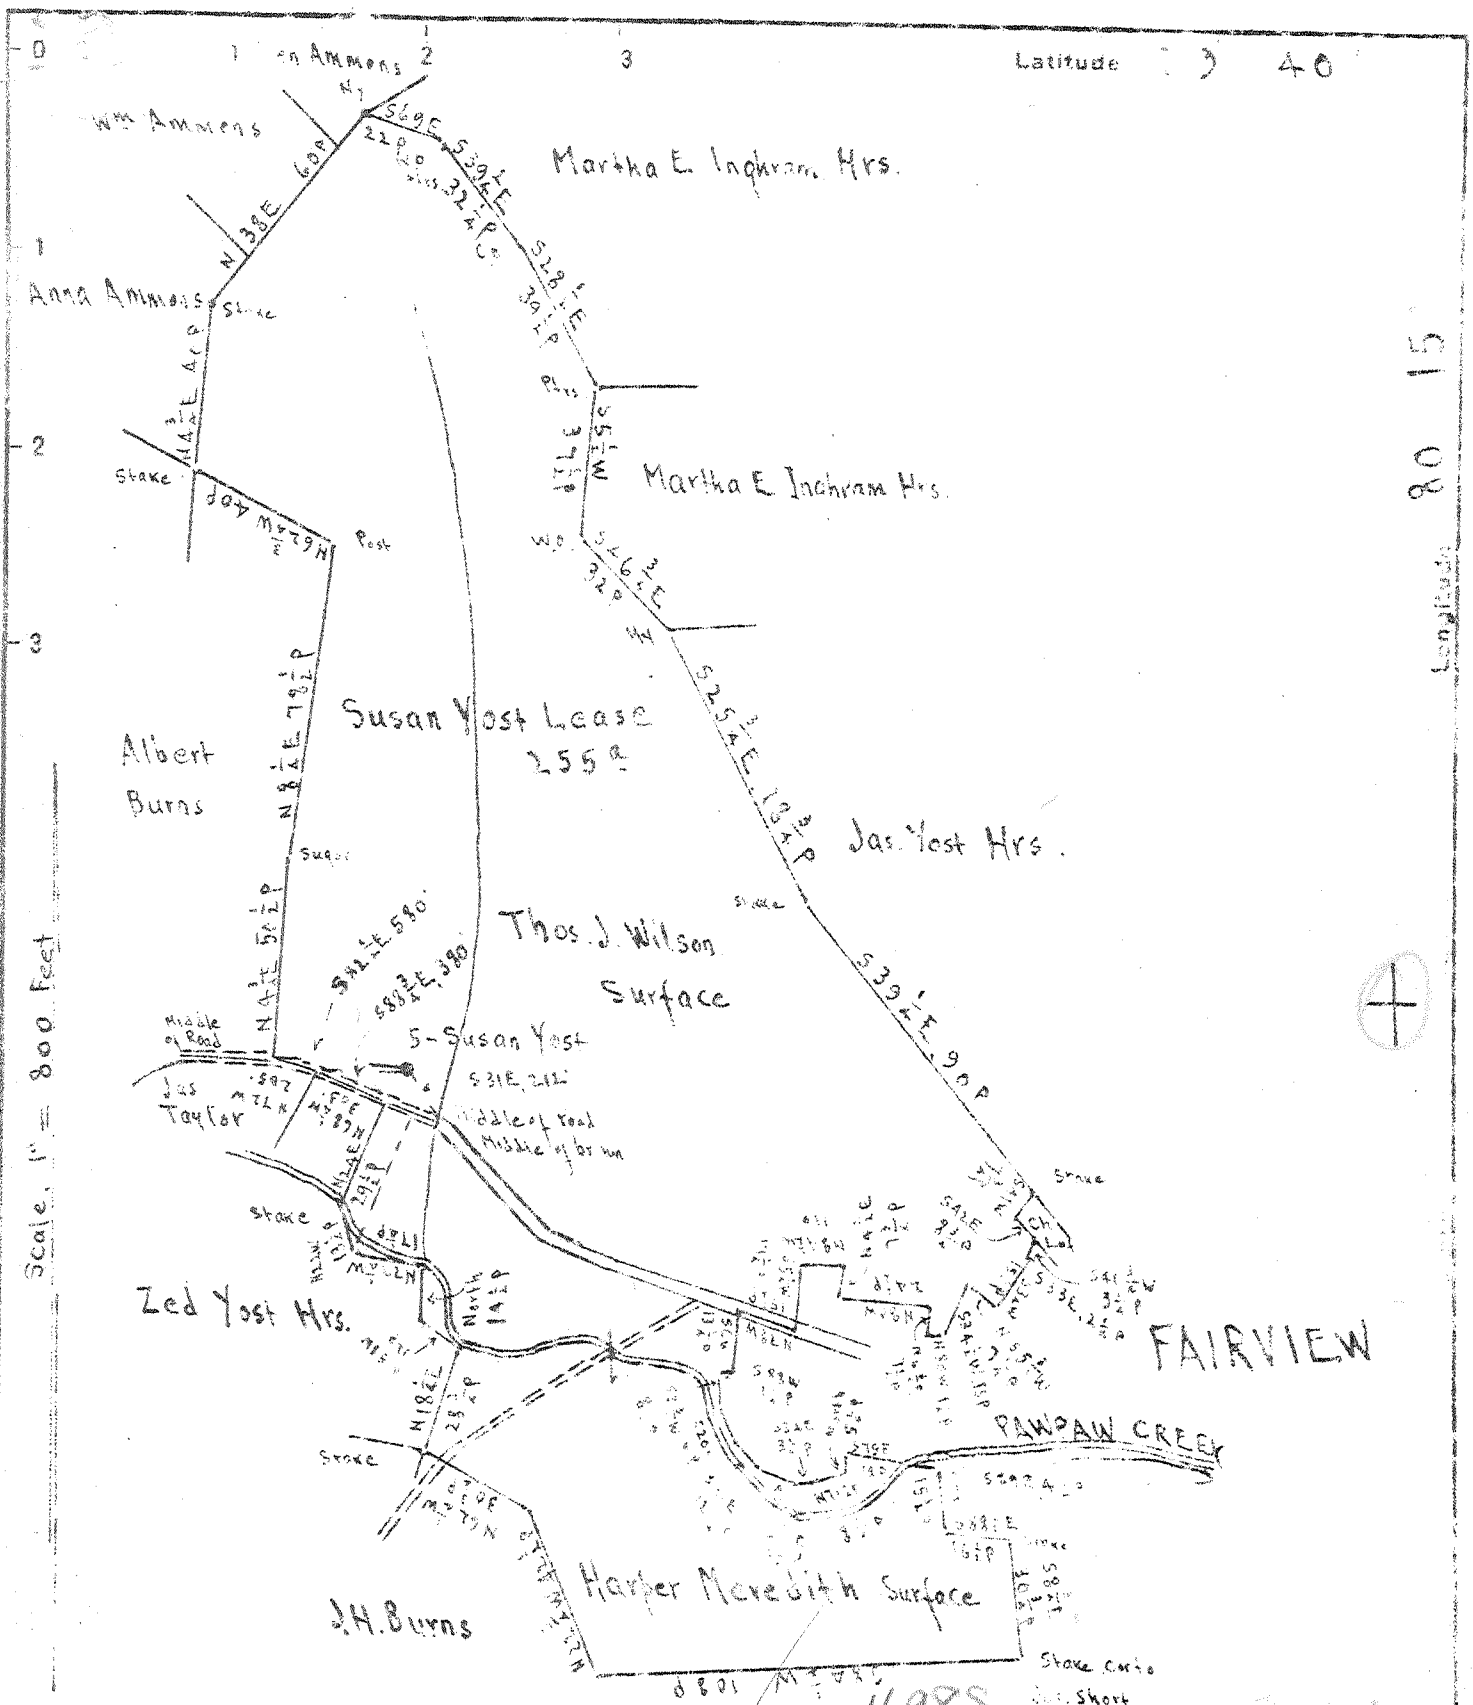

Surface: Thos. J. Wilson; 309 High St., Fairmont, W. Va.
 Pittsburgh Coal: The Union Trust Co. of Pittsburgh, Pa., Trustee.
 JUN 15 1948
 Dr. 400 Map # 2560. N10 E 20-21

Company Evaluation & Sales Service
 Address Mount Pleasant Michigan
 Farm Susan Yost
 Tract _____ Acres 2.55 Lesse No. _____
 Well (Farm) No. 5 Serial No. _____
 Elevation (Spirit Level) Floor 1064.47
 Ground 1062.87
 Quadrangle MANNINGTON
 County Marion District Pawpaw
 Engineer E.C. Tabler
 Engineer's Registration No. _____
 File No. _____ Drawing No. _____
 Date Jan 28th 1948 Scale 1" = 800 Feet

STATE OF WEST VIRGINIA
 DEPARTMENT OF MINES
 OIL AND GAS DIVISION
 CHARLESTON

WELL LOCATION MAP
 FILE NO. MAR-523-A

✦ Denotes location of well on United States Topographic Maps, scale 1 to 62,500, latitude and longitude lines being represented by border lines as shown.

— Denotes one inch spaces on border line of original tracing.

