

**Latitude**

**Longitude**



**Topo Location**

7.5' Loc. \_\_\_\_\_ 15' Loc. \_\_\_\_\_  
 \_\_\_\_\_ (calc.) \_\_\_\_\_

Company \_\_\_\_\_

Farm \_\_\_\_\_


15' Quad \_\_\_\_\_  
(sec.)

7.5' Quad Mammington

District Lincoln

**WELL LOCATION PLAT**

County 049 Permit 30525

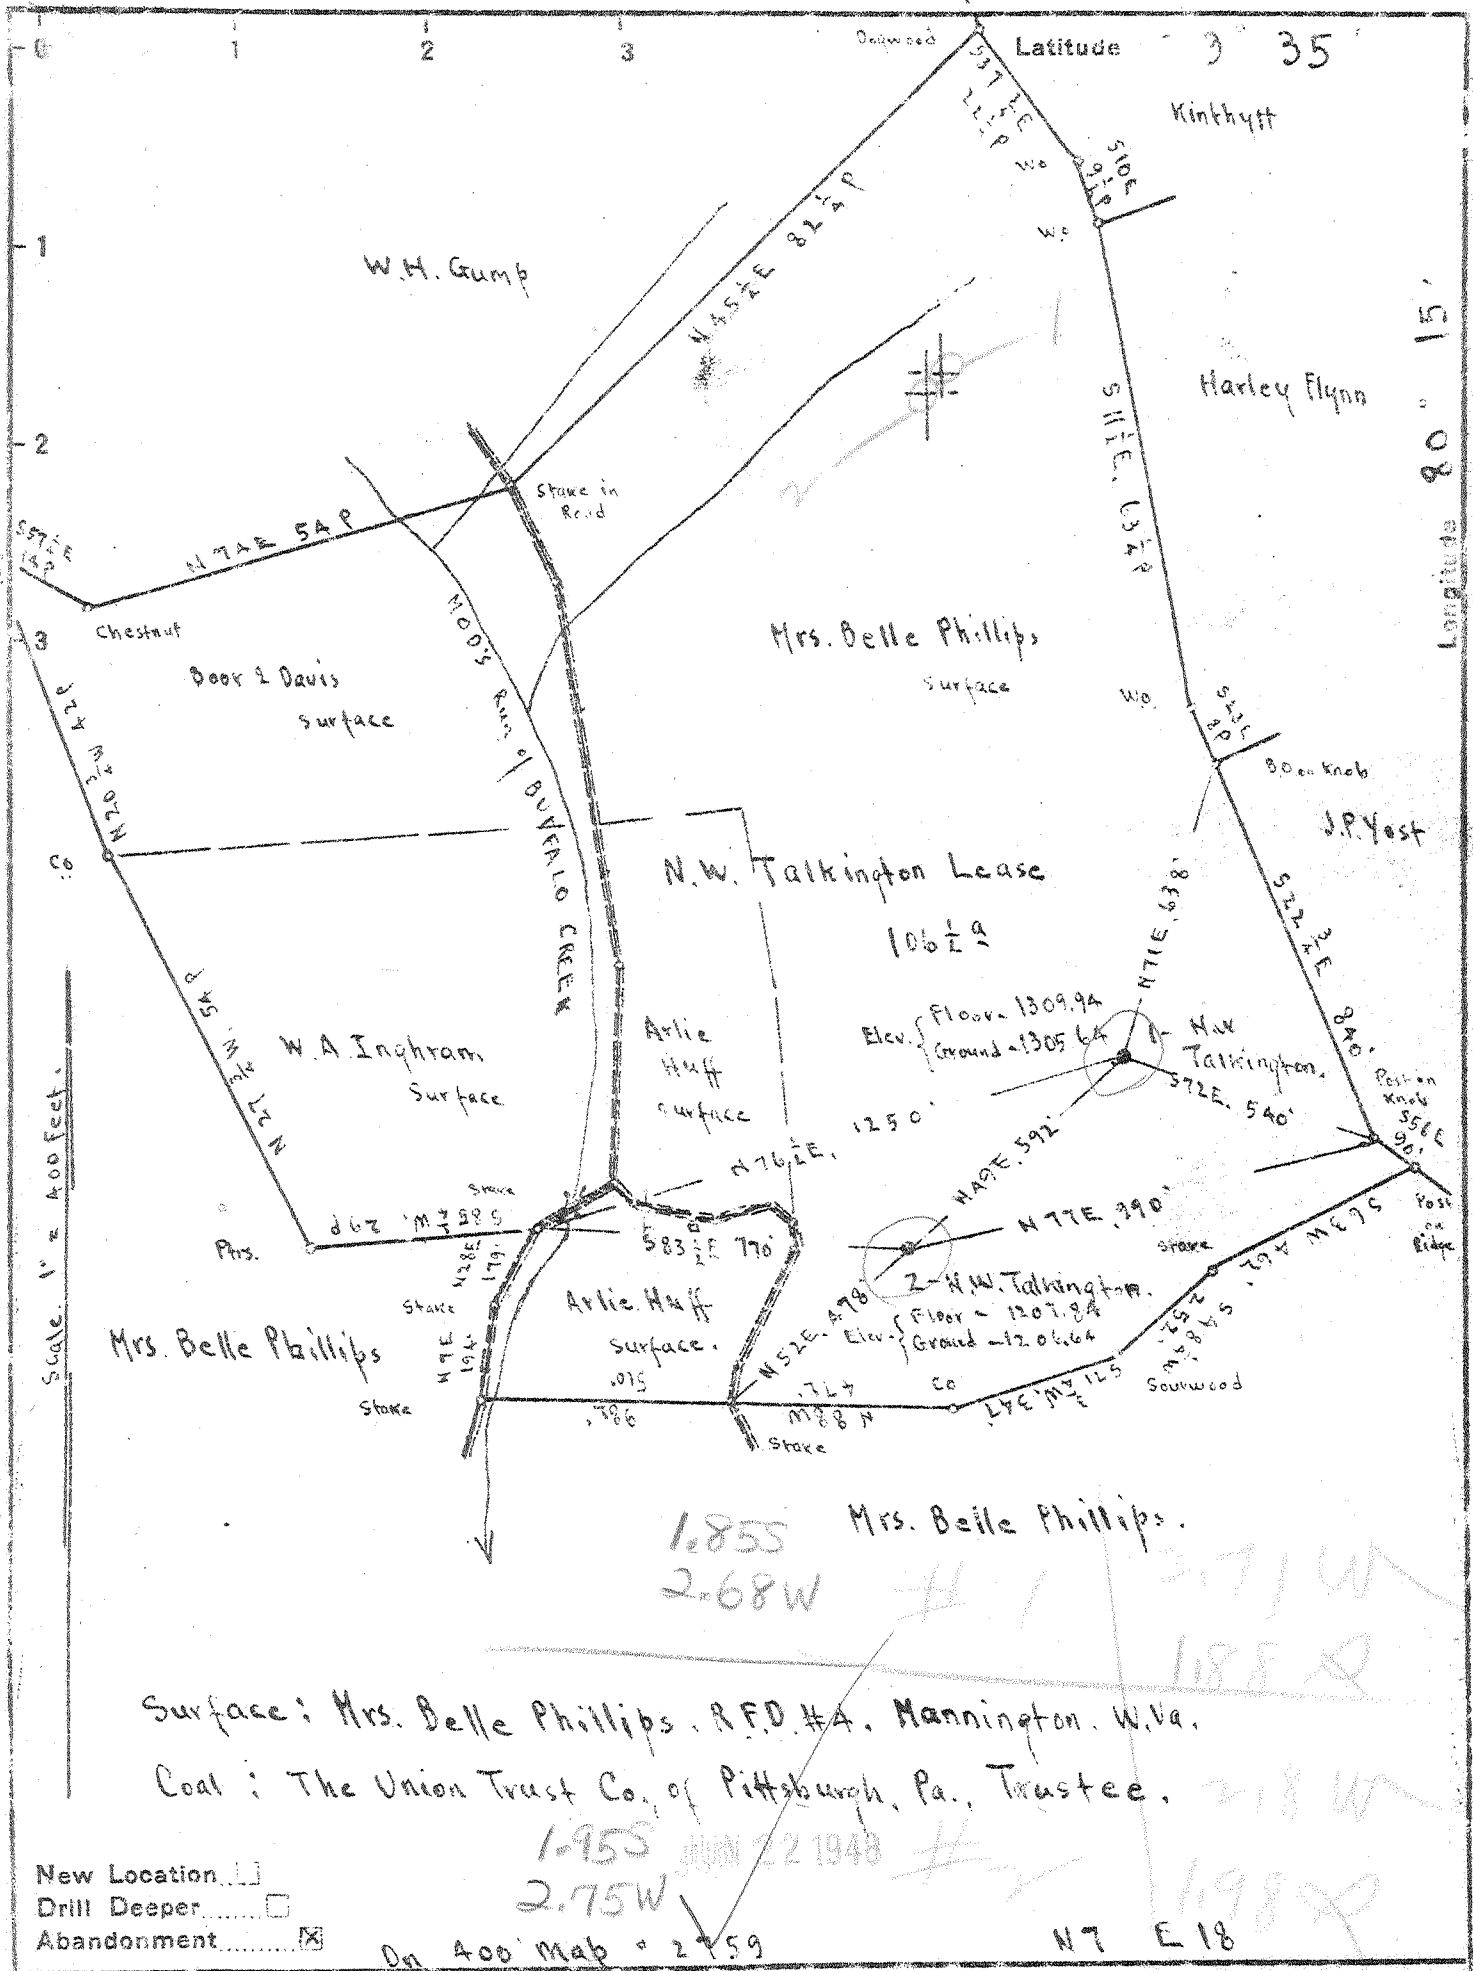

Surface: Mrs. Belle Phillips, RFD #A, Mannington, W. Va.

Coal: The Union Trust Co., of Pittsburgh, Pa., Trustee.

New Location   
 Drill Deeper   
 Abandonment

On 400' Map = 2759

Company Road Supply Co.  
 Address Salem, W. Va.  
 Farm N.W. Talkington  
 Tract  Acres 106 1/2 Lease No. \_\_\_\_\_  
 Well (Farm) No. 192 Serial No. \_\_\_\_\_  
 Elevation (Spirit Level) See above at wells  
 Quadrangle MANNINGTON SE  
 County Marion District Lincoln  
 Engineer E. C. Tabler  
 Engineer's Registration No. \_\_\_\_\_  
 File No. \_\_\_\_\_ Drawing No. \_\_\_\_\_  
 Date May 21<sup>st</sup> 1948 Scale Scale 1" = 400 Feet.

STATE OF WEST VIRGINIA  
 DEPARTMENT OF MINES  
 OIL AND GAS DIVISION  
 CHARLESTON

WELL LOCATION MAP  
 FILE NO. MAR-524-A-#1  
MAR-525-A-#2

+ Denotes location of well on United States Topographic Maps, scale 1 to 62,500, latitude and longitude lines being represented by border lines as shown.  
 - Denotes one inch spaces on border line of original tracing.



600

STATE OF WEST VIRGINIA  
DEPARTMENT OF MINES  
OIL AND GAS DIVISION

WELL RECORD

Permit No. 575-A

Oil or Gas Well (KIND)

Company Read Supply Company  
 Address 184 East Main St., Salem, W. Va.  
 Farm N. W. Talkington Acres 106 1/2  
 Location (waters).....  
 Well No. 2 Elev. 1278 1/2  
 District Lincoln County Marion 1306 6/8  
 The surface of tract is owned in fee by.....  
 Address.....  
 Mineral rights are owned by.....  
 Address.....  
 Drilling commenced.....  
 Drilling completed March 2, 1923  
 Date Shot..... From..... To.....  
 With.....  
 Open Flow /10ths Water in..... Inch  
 /10ths Merc. in..... Inch  
 Volume..... Cu. Ft.  
 Rock Pressure..... lbs..... hrs.  
 Oil..... bbls., 1st 24 hrs.  
 Fresh water..... feet..... feet  
 Salt water..... feet..... feet

Casing and Tubing	Used in Drilling	Left in Well	Packers
Size			
16			Kind of Packer.....
13			
10	720'	720'	Size of.....
8 1/2	1532'	1532'	
6 5/8	1974'	1974'	Depth set.....
5 3/16	2629'	2629'	
3			Perf. top.....
2			Perf. bottom.....
Liners Used			Perf. top.....
4" x 4 1/2"	284'	284'	Perf. bottom.....

CASING CEMENTED. No. SIZE No. Ft. Date  
 COAL WAS ENCOUNTERED AT 680 FEET 84 INCHES  
575 FEET 60 INCHES FEET INCHES  
 FEET INCHES FEET INCHES

Formation	Color	Hard or Soft	Top	Bottom	Oil, Gas or Water	Depth Found	Remarks
Conductor				16'			
Mapletown Coal			570	575			
Pittsburgh Coal			673	680			
Little Dunkard			1080	1110			
Big Dunkard			1148	1241			
1st Salt Sand			1510	1550			
Little Lime			1925	1935			
Pencil Cave			1935	1944			
Big Lime			1944	2000			
Big <del>lime</del> Injun			2000	2185			
Oil Show			2094		Oil Show		
Oil Show			2115	2122	Oil Show		
Fifty Foot			2609	2660			
Stray			2868	2893			
Gordon			2911	2933			
Hole reduced				2917			
Fourth Sand			2935	2975			
Gas			3062		Gas		
Fifth Sand			3093	3097			

