


Latitude 39° 35'

Longitude 80° 15'

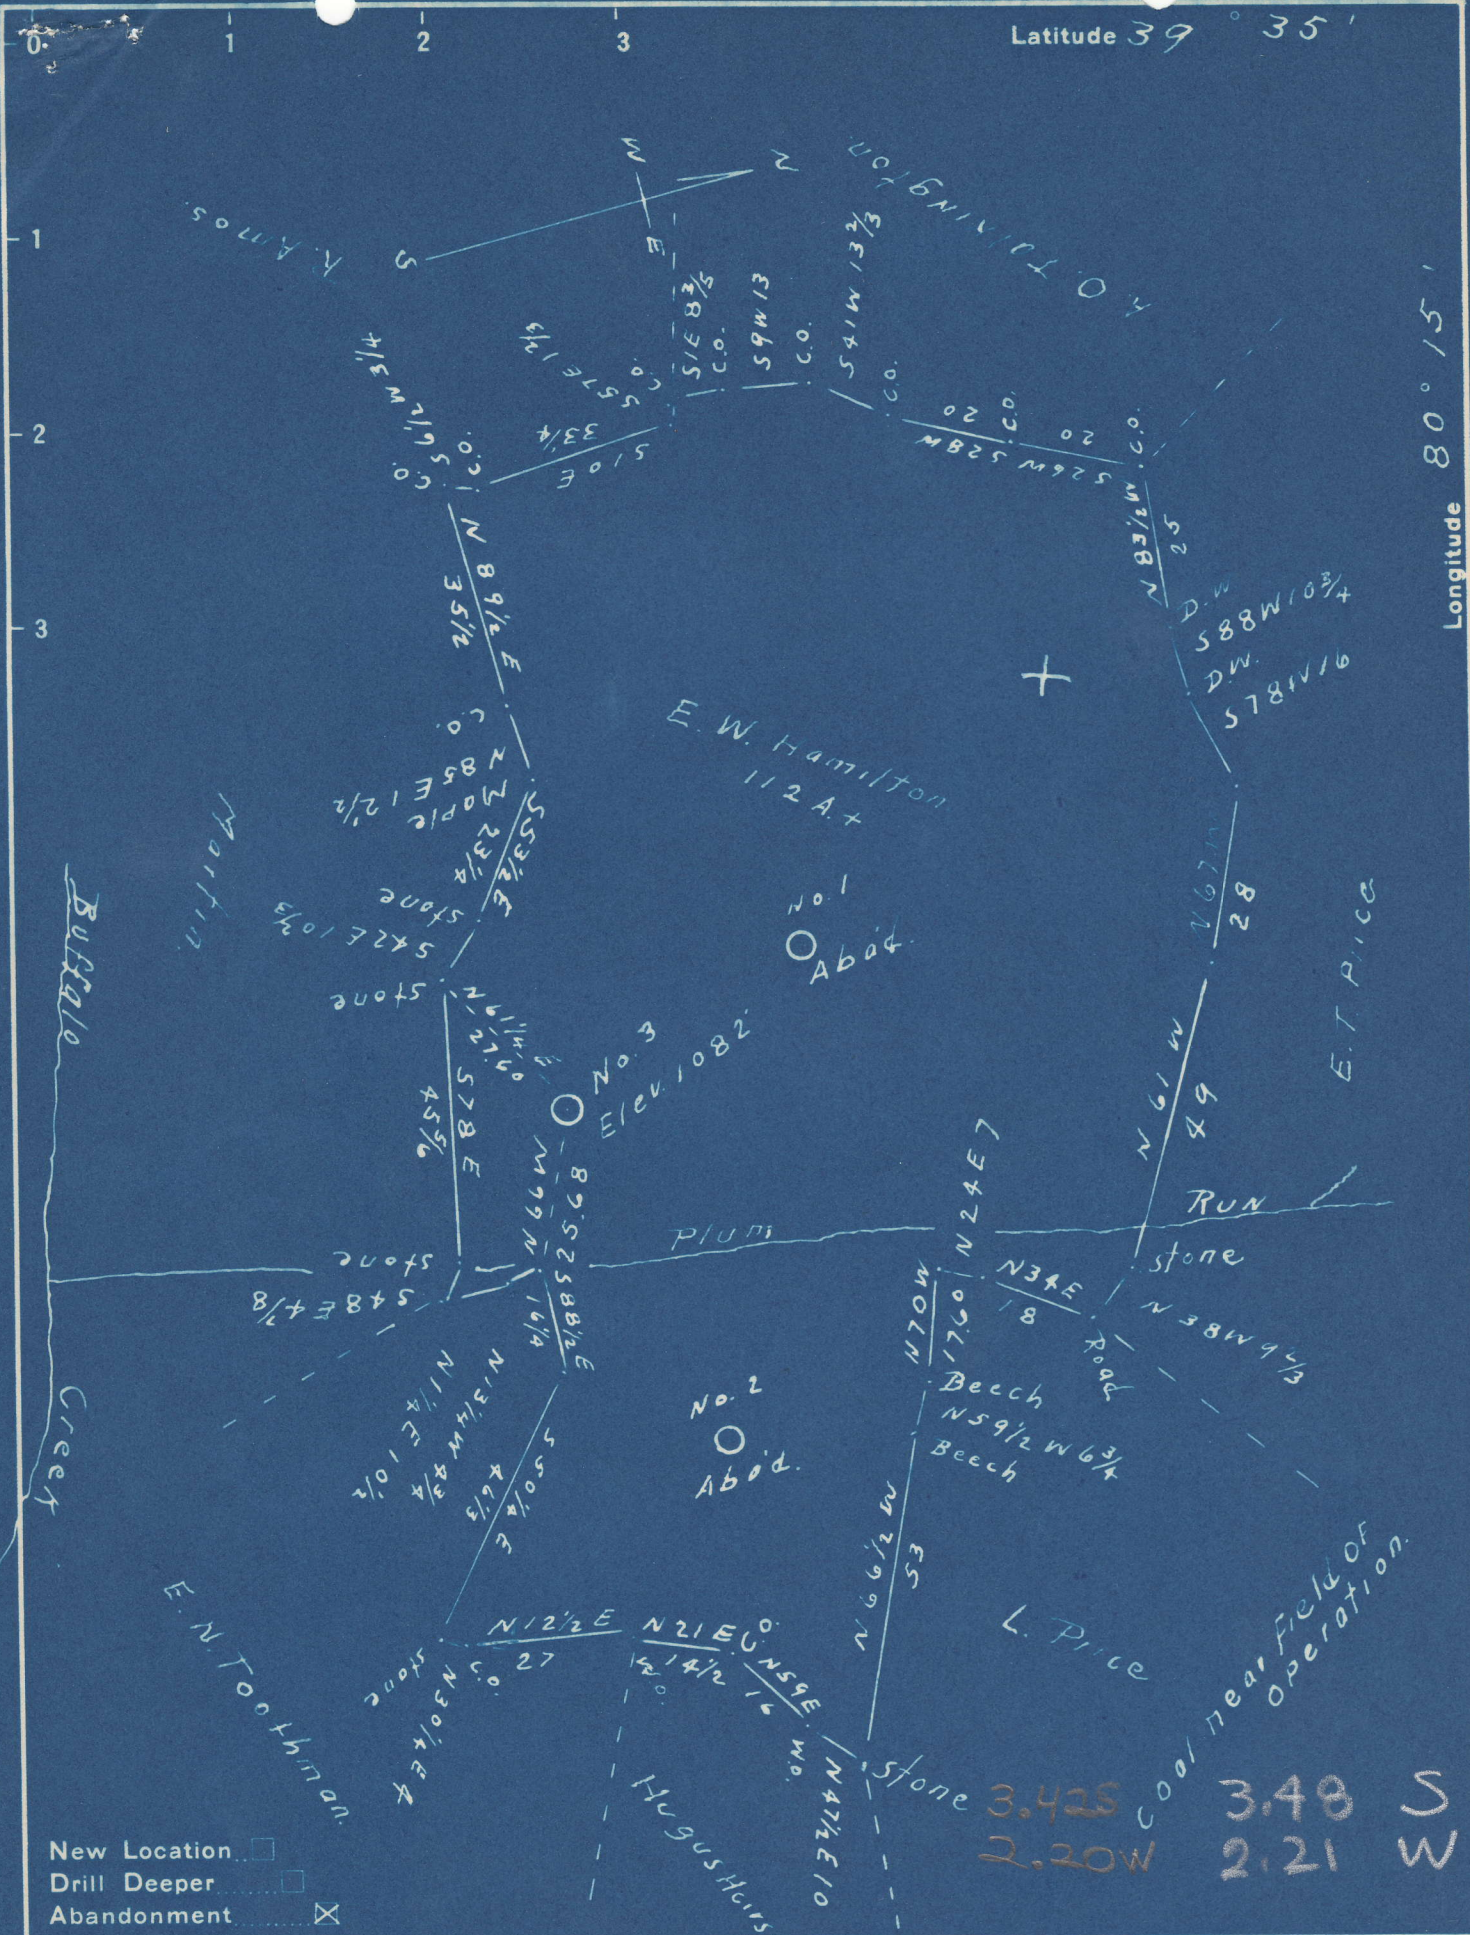

Company W. R. COREY
 Address UNIONTOWN PA.
 Farm E. W. HAMILTON
 Tract One Acres 112+ Lease No. _____
 Well (Farm) No. 3 Serial No. SE
 Elevation (Spirit Level) 1082 Feet
 Quadrangle Manawgton
 County Marion District Lincoln
 Engineer J. M. Cochran
 Engineer's Registration No. Pa. Surveyor
 File No. _____ Drawing No. _____
 Date 9-8-1948 Scale 1 inch = 30 Rods.

STATE OF WEST VIRGINIA
 DEPARTMENT OF MINES
 OIL AND GAS DIVISION
 CHARLESTON
WELL LOCATION MAP
 FILE NO. MAR-555-A

+ Denotes location of well on United States Topographic Maps, scale 1 to 62,500, latitude and longitude lines being represented by border lines as shown.
 - Denotes one inch spaces on border line of original tracing.

Mineral District, Wayne County, N. C.

By F. B. Dreyer, Mineralogist, U. S. G. S.

Revised under permit No. 1000-1000

In 112 acres, on Farm No.

Location, 1880' E.

Drilling commenced Aug. 1, 1914; completed Oct. 14, 1914.

Shot Jan. 8, 1915, with 10 qts.; Mar. 12, 1915, with 60 qts.

No record of water.

1st casing, 225' (capped); 2nd, 180'; 3rd, 190'; 4th, 190';

5th casing, 290'.

Coal was encountered at 187'.

Shot well. Record to depth of casing stopped Sept. 21, 1915.

Record to 210 from Sec. 61 with Jan. 27, 1916. (U. S. File No. 67).

	Top.	Bottom.
Pittsburgh Coal	187	...
1st Sand	187	190
Big Water Sand (sec. 190')	190	190
1st-2nd Sand (sec. 190')	190	210
2nd Sand	210	270
3rd Sand (sec. 270')	270	290
Total depth		297



STATE OF WEST VIRGINIA
DEPARTMENT OF MINES
OIL AND GAS DIVISION

574

WELL RECORD

Permit No. 555-A

Oil or Gas Well Gas
(KIND)

Company W. R. Corey
 Address Uniontown, Pa.
 Farm E. W. Hamilton Acres 112
 Location (waters) Plum Run
 Well No. 5 Elev. 1082
 District Lincoln County Marion
 The surface of tract is owned in fee by _____
 Address _____
 Mineral rights are owned by _____
 Address _____
 Drilling commenced Aug. 1, 1904
 Drilling completed Oct. 10, 1904
 Date Shot See Below From _____ To _____
 With _____
 Open Flow /10ths Water in _____ Inch
 /10ths Merc. in _____ Inch
 Volume _____ Cu. Ft.
 Rock Pressure _____ lbs. _____ hrs.
 Oil _____ bbls., 1st 24 hrs.
 Fresh water No Record feet _____ feet
 Salt water No Record feet _____ feet

Casing and Tubing	Used in Drilling	Left in Well	Packers
Size			
16			Kind of Packer
13			
10	299	pulled	Size of
8 1/4	1004	1004	
6 5/8	1524	1524	Depth set
5 3/16	1976	1976	
3			Perf. top
2	2948	2948	Perf. bottom
Liners Used			Perf. top
			Perf. bottom

CASING CEMENTED _____ SIZE _____ No. Ft. _____ Date _____

COAL WAS ENCOUNTERED AT 485 FEET ? INCHES
 _____ FEET _____ INCHES FEET _____ INCHES
 _____ FEET _____ INCHES FEET _____ INCHES

Formation	Color	Hard or Soft	Top	Bottom	Oil, Gas or Water	Depth Found	Remarks
Pittsburgh Coal			485				
Salt Sand			1395	1510			
Injun Sand			1820	1960	Gas	1940	
Fifty Foot			2400	2460	Gas	2412	
Gordon Sand			2730	2752			
Fourth Sand			2880	2883	Gas	2880	
Total Depth				2927			

Shooting Record

Date	Qts.
3-8-10	10
3-10-10	60

