

Latitude 39° 35'

Longitude 80° 08'

Ice Land

N 40 1/2 E

35

A. L. + Dove B.
Dudley
24 3/4 A.

ERRAL. Morgan.

N


27 1/2

111

114

47 1/2

No. 1
Elev. 1217

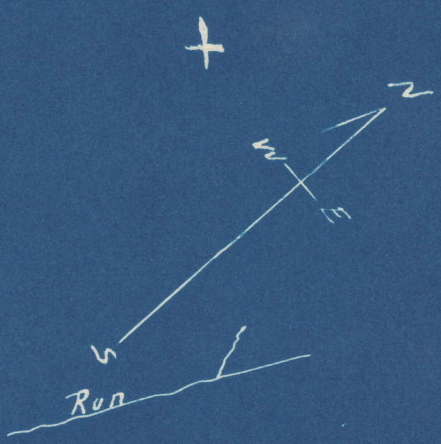

coal operated.

3.34 S
1.96 W

3.40 S
2.00 W

Boor Land

- New Location...
- Drill Deeper...
- Abandonment...

Company W. R. COREY.
 Address UNIONTOWN. PA.
 Farm A. L. + Dove B. Dudley.
 Tract One Acres 24 3/4 Lease No. _____
 Well (Farm) No. 1 Serial No. _____
 Elevation (Spirit Level) 1217 Feet
 Quadrangle Blacksville **SW**
 County Marion District Lincoln
 Engineer J. M. Cochran
 Engineer's Registration No. Co. Surveyor
 File No. _____ Drawing No. _____
 Date 9-13-1948 Scale 1 inch = 15 Rods

STATE OF WEST VIRGINIA
 DEPARTMENT OF MINES
 OIL AND GAS DIVISION
 CHARLESTON

WELL LOCATION MAP
 FILE NO. MAR-558-A

+ Denotes location of well on United States Topographic Maps, scale 1 to 62,500, latitude and longitude lines being represented by border lines as shown.

- Denotes one inch spaces on border line of original tracing.



STATE OF WEST VIRGINIA
DEPARTMENT OF MINES
OIL AND GAS DIVISION

728

WELL RECORD

Permit No. 558-A Oil or Gas Well X (KIND)

Company W. R. Corey
 Address Uniontown, Pa.
 Farm A.L. Dove B. Dudley Acres 24 3/4
 Location (waters) Davy Run
 Well No. 1 Elev 1217
 District Lincoln County Marion
 The surface of tract is owned in fee by _____
 Address _____
 Mineral rights are owned by _____
 Address _____
 Drilling commenced Dec. 2, 1921
 Drilling completed Jan. 26, 1922
 Date Shot See below From _____ To _____
 With _____
 Open Flow /10ths Water in _____ Inch
 /10ths Merc. in _____ Inch
 Volume _____ Cu. Ft.
 Rock Pressure _____ lbs. _____ hrs.
 Oil _____ bbls., 1st 24 hrs.
 Fresh water 130'-431' feet _____ feet
 Salt water 1299'-1477'-1514' feet _____ feet

Casing and Tubing Size	Used in Drilling	Left in Well	Packers
16			Kind of Packer
13			
10	616'10"	616'10"	Size of
8 1/4	1259'	1259'	Depth set
6 5/8	1829'	1829'	
5 3/16	2753'	Pulled	
3			Perf. top
2	2031'	Pulled	Perf. bottom
Liners Used			Perf. top
			Perf. bottom

CASING CEMENTED 10" SIZE No. Ft. 1-3-22 Date
Top-505'-Bottom-616'10"
 COAL WAS ENCOUNTERED AT 547 FEET 84 INCHES
 FEET INCHES FEET INCHES
 FEET INCHES FEET INCHES

Formation	Color	Hard or Soft	Top	Bottom	Oil, Gas or Water	Depth Found	Remarks
Pittsburgh	Coal		547	554	Water	130	
Murphy	Sand		773	794	"	431	
Dunkard	Sand		1043	1074	Gas	550 & 781	
Salt	Sand		1276	1592	Water	1477-1514	
Maxon	Sand		1667	1679	Gas	1299	
Injun	Sand		1861	1988	Gas	1896-1901	
Berea	Sand		2089	2104	Gas	1970-1978	
Gantz	Sand		2383	2425			
Fifty-Foot			2437	2483			
Thirty Foot			2495	2547			
Fourth Sand			2828	2841			
Fifth Sand			2899	2930			
Drilled deeper (no date)				3060			
Filled back to				2024			
Total Depth (now)				2024			

Shooting

Date	Qts	Sand
3-10-25	15	Injun
5-3-44	40	"



MAR 6 1950