


Latitude  $+39^{\circ} 35'$

Scale 1" = 400 Feet

METZ

RA Moffett Hrs.

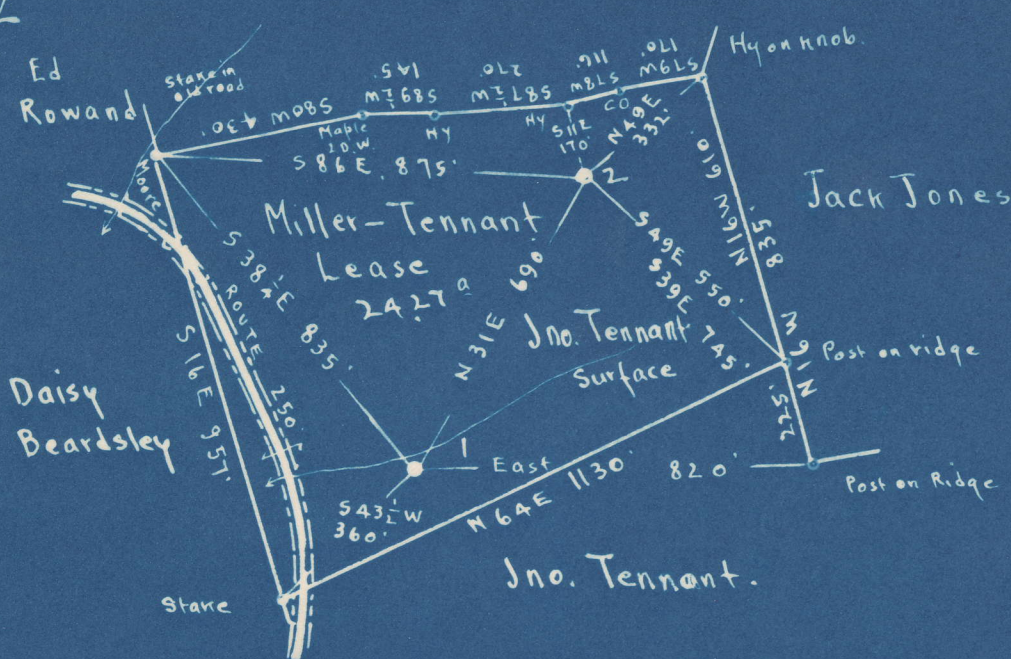

80° 10'

Longitude

	0.33S	
	1.58W	
	0.34 S	
#1	1.60 W	
#2	0.28 S	
	1.51 W	

Surface: Jno. Tennant, Shinnston, W.Va.

Coal: The Union Trust Co. of Pittsburgh, Pa. Trustee.

- New Location...
- Drill Deeper...
- Abandonment...

On 400' map # 2657.

N 9 E 15

Company The Tri-State Pipe Co.  
 Address Bellaire, Ohio  
 Farm Miller-Tennant  
 Tract \_\_\_\_\_ Acres 2427 Lease No. \_\_\_\_\_  
 Well (Farm) No. 1 & 2 Serial No. \_\_\_\_\_  
 Elevation (Spirit Level) 1 Floor 1045.76 G. 1044.78  
2 " 1283.34 G. 1281.34  
 Quadrangle MANNINGTON SE  
 County Marion District Mannington  
 Engineer E.C. Tabler  
 Engineer's Registration No. \_\_\_\_\_  
 File No. \_\_\_\_\_ Drawing No. \_\_\_\_\_  
 Date March 27<sup>th</sup> 1948 Scale 1" = 400 Feet

STATE OF WEST VIRGINIA  
 DEPARTMENT OF MINES  
 OIL AND GAS DIVISION  
 CHARLESTON

WELL LOCATION MAP  
 FILE NO. MAR-574-A-#1  
MAR-575-A-#2

+ Denotes location of well on United States Topographic Maps, scale 1 to 62,500, latitude and longitude lines being represented by border lines as shown.

- Denotes one inch spaces on border line of original tracing.

HILLIS-TENNANT NO. 2 WELL.

575A

Hennington District, Marion County, W. Va.  
 By The Tri-State Pipe Co., Bellairs, Ohio.  
 Abandoned under permit Mar-.....-AT  
 On 24.27 acres,  
 Elevation, 1281.74' L.

Surface owned by John Tennant, Shinnston, W. Va., and minerals by  
 The Union Trust Co. of Pittsburgh, Pa., Trustees.

Drilling completed March 19, 1927.

6 3/4" casing, 2303'; 5" casing, 2839'; 2" tubing, 3197'; all left in.  
 Casing not cemented.

Coal was encountered at 863-868 and 970-977'.

Oil well. Abandonment reported to Dept. of Mines Nov. 16, 1948.

Record to RGT from Mrs. Griffith Jan. 5, 1949. Old File No. 628.

	Top.	Bottom.
Conductor	0	16
Hopkinton (Sevickley) Coal	863	868
Pittsburgh Coal	970	977
Big Dunkard Sand	1464	1510
1st Salt Sand	1650	1825
Big line	2208	2265
Big Injun Sand (oil and water, 2380-2383')	2265	2425
Fifty-foot Sand	2913	2987
Thirty-foot Sand	3006	3030
Gordon Sand (gas, 3160-3165')	3144	3173
Fourth Sand (oil, 3185-3190')	3178	3195
Total depth		3197



STATE OF WEST VIRGINIA  
DEPARTMENT OF MINES  
OIL AND GAS DIVISION

678

WELL RECORD

Permit No. Ab 575-A

Oil or Gas Well X (KIND)

Company The Tri-State Pipe Co.  
Address Bellaire, Ohio  
Farm Miller-Tennant Acres 24.27  
Location (waters)  
Well No. 2 Elev. 1281.34  
District Mannington County Marion  
The surface of tract is owned in fee by John Tennant  
Address Shinnston, W. Va.  
Mineral rights are owned by The Union Trust Co., 60  
Pittsburgh, Pa., Address Trustee  
Drilling commenced  
Drilling completed March 19, 1927  
Date Shot From To  
With

Casing and Tubing	Used in Drilling	Left in Well	Packers
Size			
16			Kind of Packer
13			
10			Size of
8 1/4			
6 3/8	2303'	2303'	Depth set
5 3/16	2859'	2859'	
3			Perf. top
2	3197'	3197'	Perf. bottom
Liners Used			Perf. top
			Perf. bottom

Open Flow /10ths Water in \_\_\_\_\_ Inch  
/10ths Merc. in \_\_\_\_\_ Inch  
Volume \_\_\_\_\_ Cu. Ft.  
Rock Pressure \_\_\_\_\_ lbs. \_\_\_\_\_ hrs.  
Oil \_\_\_\_\_ bbls., 1st 24 hrs.  
Fresh water \_\_\_\_\_ feet  
Salt water \_\_\_\_\_ feet

CASING CEMENTED No SIZE \_\_\_\_\_ No. Ft. \_\_\_\_\_ Date \_\_\_\_\_

COAL WAS ENCOUNTERED AT 977 FEET 84 INCHES  
868 FEET 60 INCHES  
FEET INCHES FEET INCHES

Formation	Color	Hard or Soft	Top	Bottom	Oil, Gas or Water	Depth Found	Remarks
Conductor				16			
Pittsburgh Coal			970	977			
Mapletown Coal			863	868			
Big Dunkard			1464	1510			
1st. Salt Sand			1650	1825			
Big Lime			2208	2265			
Big Injun			2265	2425			
Oil & Water			2380	2383	Oil and water		
Fifty Foot			2913	2987			
Thirty Foot			3006	3030			
Gordon			3144	3173			
Gas			3160	3165	Gas		
Fourth			3178	3195			
Oil			318 5	3190			
Total Depth				3197			



