


Latitude 39° 40'

Longitude 80° 15'

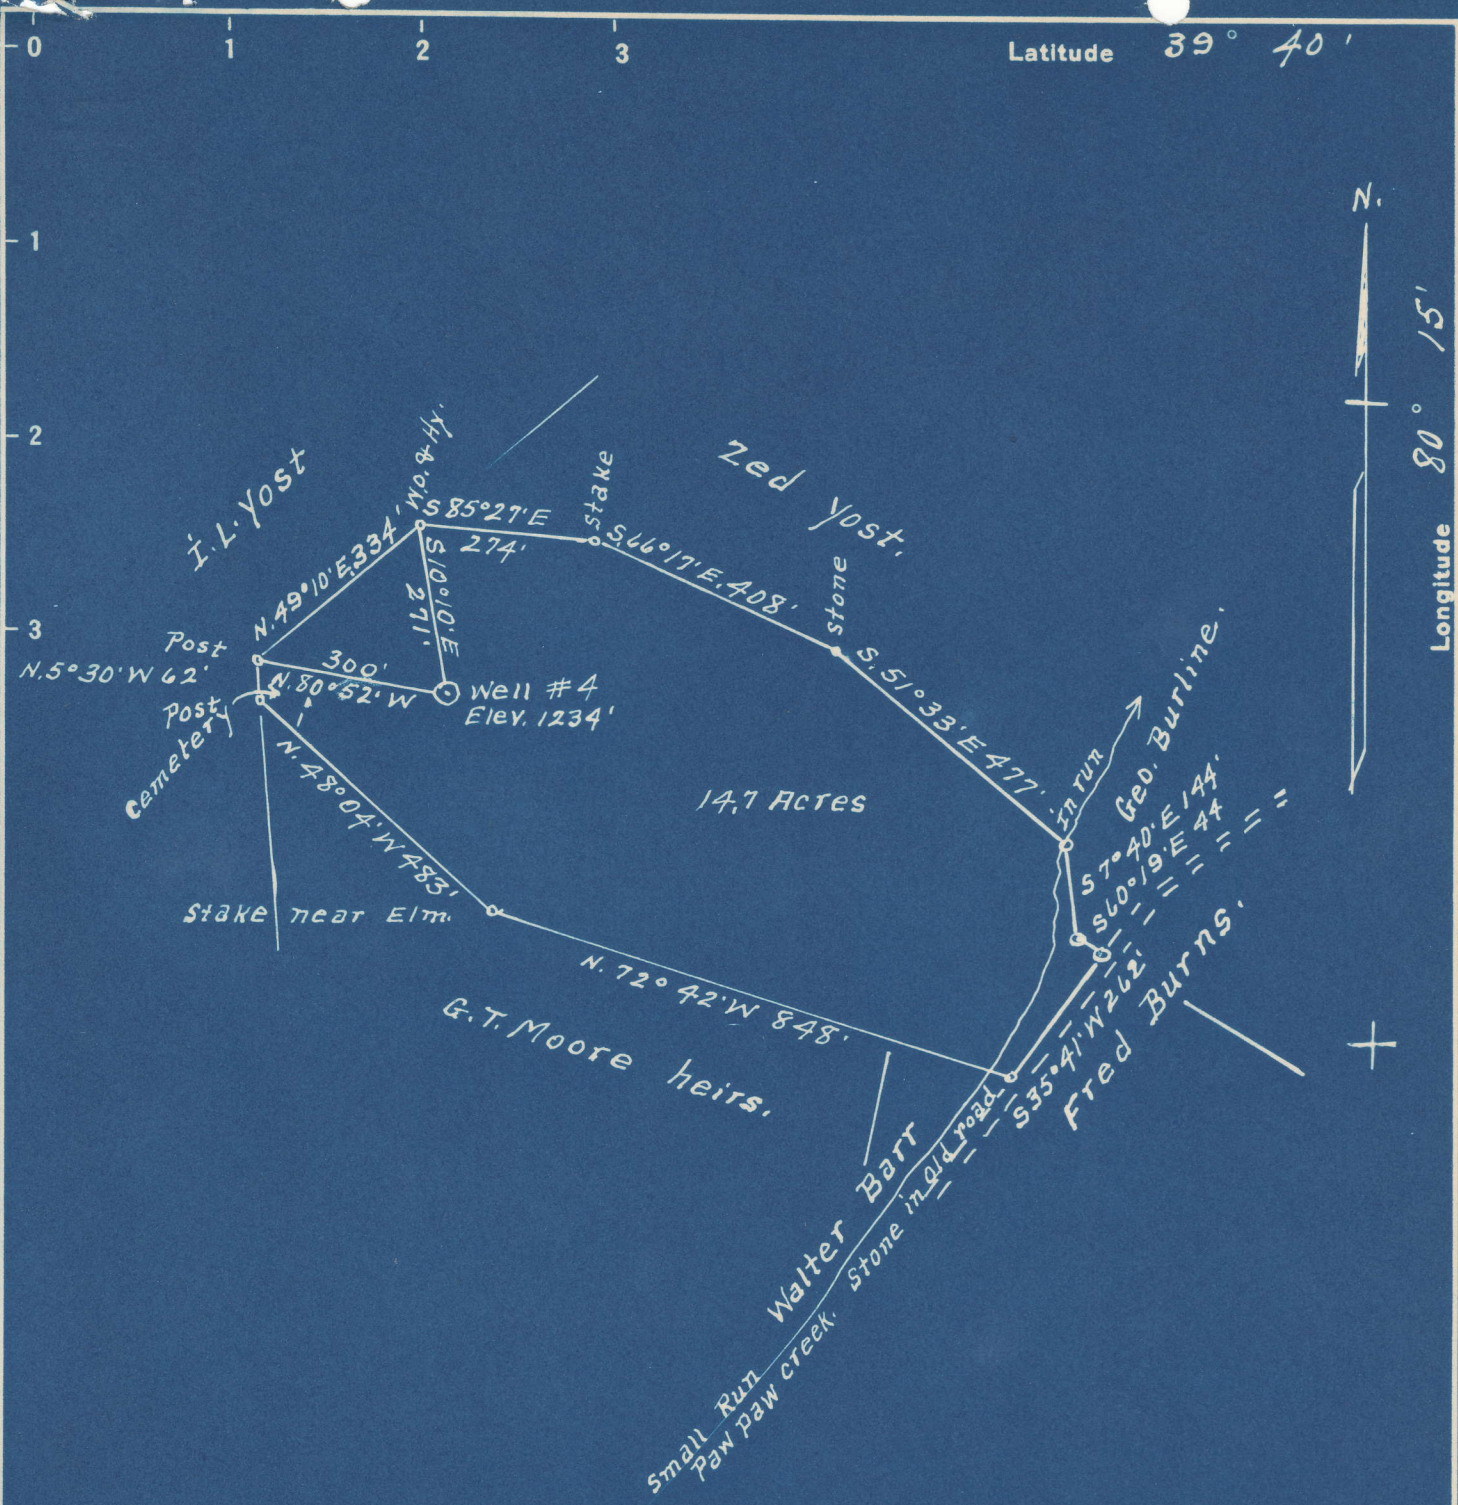

Surface = Walter Johnson
Fairmont, W Va
Coal = Union Trust Co
Pittsburgh, Pa

5.215 5.29 S
0.43W 0.42 W

New Location
Drill Deeper
Abandonment

Company A.M. Snider
Address Hundred, W Va.
Farm P.W. Yost (Lease)
Tract 1 Acres Lease 110th Lease No. 6259
Well (Farm) No. 4 Serial No. EC
Elevation (Spirit Level) 1234
Quadrangle Mannington
County Marion District Paw Paw
Engineer A.L. Headley
Engineer's Registration No. 2021
File No. _____ Drawing No. _____
Date 11-27-1948 Scale 1" = 300'

STATE OF WEST VIRGINIA
DEPARTMENT OF MINES
OIL AND GAS DIVISION
CHARLESTON

WELL LOCATION MAP
FILE NO. MAR-594-A

+ Denotes location of well on United States Topographic Maps, scale 1 to 62,500, latitude and longitude lines being represented by border lines as shown.

- Denotes one inch spaces on border line of original tracing.