

Surface owned by Eva Anderson  
 Address: Mrs. Eva Anderson, R.F.D.No. 1, Mannington, W.Va.  
 Coal owned by Isaac VanVoorhis et al.  
 Address: Isaac VanVoorhis, % Farmers & Merchants National Bank,  
 Morgantown, W.Va.

- New Location...
- Drill Deeper.....
- Abandonment.....

On 400' Map Sheet No. 2654, Sqs. N 7-8 E 9-10.

Company Road Supply Company  
 Address Salem, W. Va.  
 Farm E.S. Evans  
 Tract \_\_\_\_\_ Acres 100 Lease No. SW  
 Well (Farm) No. 6 Serial No. \_\_\_\_\_  
 Elevation (Spirit Level) Floor - 1110.83  
Ground - 1107.53  
 Quadrangle Mannington  
 County Marion District Mannington  
 Engineer A. L. Headley  
 Engineer's Registration No. 2021  
 File No. \_\_\_\_\_ Drawing No. \_\_\_\_\_  
 Date Jan. 19th, 1949 Scale 1" = 400 Feet

STATE OF WEST VIRGINIA  
 DEPARTMENT OF MINES  
 OIL AND GAS DIVISION  
 CHARLESTON

**WELL LOCATION MAP**  
 FILE NO. MAR-601-A

+ Denotes location of well on United States Topographic Maps, scale 1 to 62,500, latitude and longitude lines being represented by border lines as shown.  
 - Denotes one inch spaces on border line of original tracing.



H. S. EVANS NO. 6 WELL.

601A

Mannington District, Marion County, W. Va.  
 By Raad Supply Co., 184 E. Main St., Salem, W. Va.  
 Abandoned under permit Mar-.....-A?

On 100 acres, on Evans Run.

Elevation, 1107.53' L.

Surface owned by Mrs. Eva Anderson, R. F. D. No. 1, Mannington, W. Va.,  
 and minerals by Isaac Van Voorhis, Farmers & Merchants Bank,  
 Morgantown, W. Va.

Drilling completed April 19, 1916.

10" casing, 160' (pulled); 8½", 1435' (pulled); 5½", 1984'; 2" tubing,  
 2131'.

Casing not cemented.

Coal was encountered at 950-957'.

Oil well. Abandonment reported to Dept. of Mines Jan. 25, 1949.

Record to RCT from Mrs. Griffith March 17, 1949. Old File No. 660.

	Top.	Bottom.
Pittsburgh Coal	950	957
Big Dunkard Sand	1450	1510
Salt Sand	1855	1890
Maxton Sand (gas, 2057') (oil, 2065')		
(oil, 2069') (oil, 2087')	2043	....
Little Lime	2088	2091
Total depth		2131





660

STATE OF WEST VIRGINIA  
DEPARTMENT OF MINES  
OIL AND GAS DIVISION

WELL RECORD

Permit No. 601-A

Oil or Gas Well X  
(KIND)


Company Raad Supply Company  
Address 184 East Main Street, Salem, W. Va.  
Farm E. S. Evans Acres 100  
Location (waters) Evans Run  
Well No. 6 Elev. 1107.53  
District Mannington County Marion  
The surface of tract is owned in fee by Mrs. Eva Anderson  
R. F. D. #1 Address Mannington, W. Va.  
Mineral rights are owned by Isaac Van Voorhis  
% Farmers & Merchants Nat'l Bank  
Morgantown, W. Va.  
Drilling commenced \_\_\_\_\_  
Drilling completed April 19, 1916  
Date Shot \_\_\_\_\_ From \_\_\_\_\_ To \_\_\_\_\_  
With \_\_\_\_\_

Casing and Tubing	Used in Drilling	Left in Well	Packers
Size			Kind of Packer
16			
13			
10	<u>160'</u>	<u>None</u>	Size of
8 1/4	<u>1435'</u>	<u>None</u>	
6 5/8			Depth set
5 3/16	<u>1984'</u>	<u>1984'</u>	
3			Perf. top
2	<u>2131'</u>	<u>2131'</u>	Perf. bottom
Liners Used			Perf. top
			Perf. bottom

Open Flow \_\_\_\_\_ /10ths Water in \_\_\_\_\_ Inch  
\_\_\_\_\_ /10ths Merc. in \_\_\_\_\_ Inch  
Volume \_\_\_\_\_ Cu. Ft.  
Rock Pressure \_\_\_\_\_ lbs. \_\_\_\_\_ hrs.  
Oil \_\_\_\_\_ bbls., 1st 24 hrs.  
Fresh water \_\_\_\_\_ feet \_\_\_\_\_ feet  
Salt water \_\_\_\_\_ feet \_\_\_\_\_ feet

CASING CEMENTED No SIZE \_\_\_\_\_ No. Ft. \_\_\_\_\_ Date \_\_\_\_\_  
COAL WAS ENCOUNTERED AT 957 FEET 84 INCHES  
\_\_\_\_\_ FEET \_\_\_\_\_ INCHES FEET \_\_\_\_\_ INCHES  
\_\_\_\_\_ FEET \_\_\_\_\_ INCHES FEET \_\_\_\_\_ INCHES

Formation	Color	Hard or Soft	Top	Bottom	Oil, Gas or Water	Depth Found	Remarks
Pittsburgh Coal			950	957			
Big Dunkard			1450	1510			
Salt Sand			1855	1890			
Maxon Sand			2045				
Gas			2057		Gas		
Oil			2065		Oil		
Oil			2069		Oil		
Oil			2087		Oil		
Little Lime			2088	2091			
Total Depth				2131			

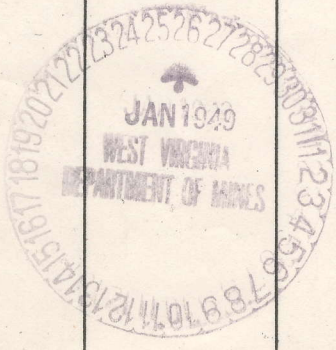



Formation	Color	Hard or Soft	Top	Bottom	Oil, Gas or Water	Depth Found	Remarks
			8080	8087			
			8093		Oil		
			8098		Oil		
			8099		Oil		
			809A		Oil		
			809B				
			809C				
			809D				
			809E				
			809F				
			809G				
			809H				
			809I				
			809J				
			809K				
			809L				
			809M				
			809N				
			809O				
			809P				
			809Q				
			809R				
			809S				
			809T				
			809U				
			809V				
			809W				
			809X				
			809Y				
			809Z				

DEPARTMENT OF MINES  
STATE OF WEST VIRGINIA

Date January 25, 1949

APPROVED Road Supply Co., Owner

By J. M. Road, mg, owner  
(Title) sm

MATHews PRINTING AND LITHOGRAPHING CO.  
CHARLESTON, W. VA.