

Surface: Pete Stetar et. ux.
 Route # 2, Fairmont, W. Va.
 Coal: Koppers Coal Co.
 Grant Town, W. Va.

1.90S
 1.40W
 1.74 S
 1.41 W

New Location
 Drill Deeper
 Abandonment

Company Harry C. Isabel.
 Address 309 Morgantown, St
Uniontown Pa
 Farm D. L. Toothman
 Tract 1 Acres 15- Lease No. 10531
 Well (Farm) No. 1 Serial No. 1946
 Elevation (Spirit Level) 1205'
 Quadrangle Blacksville SW
 County Marion District Paw Paw
 Engineer A. L. Headley
 Engineer's Registration No. 2021
 File No. _____ Drawing No. _____
 Date 1-17-49 Scale 1" = 300'

STATE OF WEST VIRGINIA
 DEPARTMENT OF MINES
 OIL AND GAS DIVISION
 CHARLESTON

WELL LOCATION MAP
 FILE NO. MAR-605-A

+ Denotes location of well on United States Topographic Maps, scale 1 to 62,500, latitude and longitude lines being represented by border lines as shown.

- Denotes one inch spaces on border line of original tracing.

D. L. TOOTHMAN NO. 1 WELL.

605A

Fawcaw District, Marion County, W. Va.

By A. M. Snider, Waynesburg, Pa.

Abandoned under permit Mar-.....-A?

#583 MMT Co Rep

On 15 acres.

Elevation, 1205' L.

Surface owned by Pete Stetar et ux, Fairmont, W. Va., and minerals by Eastern Gas Fuel Associates, Grant Town, W. Va.

Drilling commenced Aug. 10, 1910; completed Dec. 14, 1910.

Shot Dec. 14, 1910, with 20 qts., in Fifth Sand.

Salt water at 1430'.

10" casing, 534'; 8" casing, 1563'; 6" casing, 1857'; 5" casing, 2706'; 3024' (Pulled).

10" casing cemented at 530-520'.

Packers: 10 x 13, C. I. P., set at 530'; 8" shoe, 1551'; 6 x 8,

C. B. H., set at 1842'; 5 x 6, C. B. H., set at 2694'; 2 x 5,

C. B. H., set at 2789'.

Gas well. Record to Dept. of Mines stamped July 20, 1950.

Record to RCT from Mrs. Griffith June 24, 1951. Old File No. 784.

	Top.	Bottom.
Pittsburgh Coal	505	- 511
Dunkard Sand	880	- 988
Salt Sand (water, 1430')	1280	- 1492
Maxton Sand	1615	- 1635
Big Injun Sand (gas, 1933')	1842	- 1945
Gantz Sand	2047	- 2077
Fifty-foot Sand	2306	- 2375
Thirty-foot Sand	2397	- 2425
Stray Sand	2676	- 2734
Gordon Sand	2700	- 2710
Fourth Sand	2786	- 2796
Fifth Sand (gas, 2877')	2852	- 2884
Total depth		2993



STATE OF WEST VIRGINIA
DEPARTMENT OF MINES
OIL AND GAS DIVISION

742

WELL RECORD

Permit No. 605-A Oil or Gas Well X (KIND)

Company <u>Harry C. Isabel</u>	Casing and Tubing	Used in Drilling	Left in Well	Packers
Address <u>Uniontown, Pa.</u>	Size			
Farm <u>D. L. Toothman</u> Acres <u>15</u>	16			See Below
Location (waters)	13			Kind of Packer
Well No. <u>1</u> Elev. <u>1205'</u>	10	<u>534'</u>	<u>534'</u>	Size of
District <u>Paw Paw</u> County <u>Marion</u>	8 1/4	<u>1563'</u>	<u>1563'</u>	Depth set
The surface of tract is owned in fee by <u>Pete Stetar, et ux.</u> Address <u>Route #2, Fairmont, W. Va.</u>	6 5/8	<u>1857'</u>	<u>Pulled</u>	Perf. top
Mineral rights are owned by <u>Coal; Koppers Coal Co.</u> Address <u>Grant Town, W. Va.</u>	5 3/16	<u>2706'</u>	<u>2706'</u>	Perf. bottom
Drilling commenced <u>August 10, 1910</u>	3			Perf. top
Drilling completed <u>December 14, 1910</u>	2	<u>3014'</u>	<u>Pulled</u>	Perf. bottom
Date Shot <u>See Below</u> From _____ To _____	Liners Used			Perf. top
With _____				Perf. bottom
Open Flow /10ths Water in _____ Inch				
/10ths Merc. in _____ Inch				
Volume _____ Cu. Ft.				
Rock Pressure _____ lbs. _____ hrs.				
Oil _____ bbls., 1st 24 hrs.				
Fresh water _____ feet _____ feet				
Salt water <u>1430</u> feet _____ feet				


CASING CEMENTED SIZE No. Ft. Date
10" casing cemented from 530' to 520'
COAL WAS ENCOUNTERED AT 505 FEET 72 INCHES
FEET INCHES FEET INCHES
FEET INCHES FEET INCHES

Formation	Color	Hard or Soft	Top	Bottom	Oil, Gas or Water	Depth Found	Remarks
Pittsburgh Coal			505	511			
Dunkard Sand			880	988			
Salt Sand			1280	1492	Water 1430		
Maxon Sand			1615	1635			
Injun Sand			1842	1945	Gas 1933		
Gantz Sand			2047	2077			
Fifty Foot Sand			2306	2375			
Thirty Foot Sand			2397	2415			
Stray Sand			2676	2684			
Gordon Sand			2700	2710			
Fourth Sand			2786	2796			
Fifth Sand			2852	2884	Gas 2877		
TOTAL DEPTH				2993			

PACKERS

SHOOTING

Size	MAKE	SET AT	Date	Qts.	Sand
10 x 13	C. I. F.	530	12-14-10	20	Fifth
8 1/4	Shoe	1551			
6 x 8	C. B. H.	1842			
5 x 6	"	2684			
2 x 5		2789			

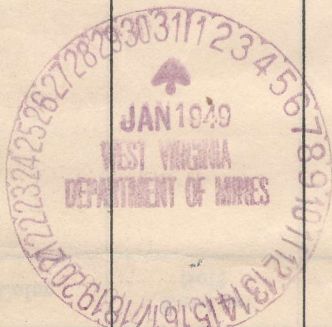

MAR 6 1950