

Company PITTSBURGH & W.VA. GAS CO.  
 Address CLARKSBURG, W.VA.  
 Farm M. L. DAWSON  
 Tract \_\_\_\_\_ Acres 116 Lease No. 14893  
 Well (Farm) No. ONE Serial No. 5292  
 Elevation (Spirit Level) 1482' V.A.  
 Quadrangle MANNINGTON N.W. 4<sup>3</sup>  
 County MARION District MANNINGTON  
 Engineer Kenneth B. Moore  
 Approved By John Dugan 764  
 Engineer's Registration No. \_\_\_\_\_  
 File No. VOL 162 P117 Drawing No. \_\_\_\_\_  
 Date MAY 31, 1949 Scale 1" = 300'

STATE OF WEST VIRGINIA  
 DEPARTMENT OF MINES  
 OIL AND GAS DIVISION  
 CHARLESTON

**WELL LOCATION MAP**  
 FILE NO. MAR-627-A

+ Denotes location of well on United States Topographic Maps, scale 1 to 62,500, latitude and longitude lines being represented by border lines as shown.

- Denotes one inch spaces on border line of original tracing.



713

STATE OF WEST VIRGINIA  
DEPARTMENT OF MINES  
OIL AND GAS DIVISION

WELL RECORD

Oil or Gas Well "GAS"  
(KIND)

Permit No. Ab 67-A

Company Pittsburgh & West Va Gas Company.  
Address Clarksburg, West Va.  
Farm N. L. Dawson Acres 116  
Location (waters) Mann. N/W. 4-3  
Well No. 5292 Elev 1482' VA  
District Mannington County Marion  
The surface of tract is owned in fee by Dayle G. Tetrick  
117 Marion Street. Address Fairmont, W. Va.  
Mineral rights are owned by Dayle G. Tetrick  
117 Marion Street Address Fairmont, West Va.

Drilling commenced January 27, 1919  
Drilling completed March 5th, 1919  
Date Shot \_\_\_\_\_ From \_\_\_\_\_ To \_\_\_\_\_  
With \_\_\_\_\_


Open Flow \_\_\_\_\_ /10ths Water in \_\_\_\_\_ Inch  
\_\_\_\_\_ /10ths Merc. in \_\_\_\_\_ Inch  
Volume \_\_\_\_\_ Cu. Ft.  
Rock Pressure \_\_\_\_\_ lbs. \_\_\_\_\_ hrs.  
Oil \_\_\_\_\_ bbls., 1st 24 hrs.  
Fresh water \_\_\_\_\_ feet \_\_\_\_\_ feet  
Salt water \_\_\_\_\_ feet \_\_\_\_\_ feet

Casing and Tubing	Used in Drilling	Left in Well	Packers
Size			
16			Kind of Packer
13			
10	306'	306'	Size of
8 1/4	1740'	1740'	
6 5/8	2517'	2517'	Depth set
5 3/16			
3			Perf. top
2			Perf. bottom
Liners Used			Perf. top
			Perf. bottom

CASING CEMENTED \_\_\_\_\_ SIZE \_\_\_\_\_ No. Ft. \_\_\_\_\_ Date \_\_\_\_\_  
COAL WAS ENCOUNTERED AT 862 FEET 60 INCHES  
1165 FEET 60 INCHES 1265 FEET 84 INCHES  
\_\_\_\_\_ FEET \_\_\_\_\_ INCHES \_\_\_\_\_ FEET \_\_\_\_\_ INCHES  
\_\_\_\_\_ FEET \_\_\_\_\_ INCHES \_\_\_\_\_ FEET \_\_\_\_\_ INCHES

Formation	Color	Hard or Soft	Top	Bottom	Oil, Gas or Water	Depth Found	Remarks
Clay	Yellow	Soft	0	25			
Slate	Dark	"	25	100			
"	White	"	100	300	Water	165'	
Lime	"	Hard	300	350			
Slate	Dark	Soft	350	425			
Red Rock	Red	"	425	475			
Lime	White	Hard	475	580			
Red Rock	Red	Soft	580	625			
Lime	White	Hard	625	725			
Red Rock	Red	Soft	725	740			
Slate	Black	"	740	825			
Lime	White	Hard	825	862			
Fairview Coal	Black	Soft	862	867			
Lime	White	Hard	867	880			
Bluff Sand	Pink	Soft	880	915			
Slate	Black	"	915	975			
Lime	White	Hard	975	1165			
M.T. Coal	Black	Soft	1165	1170			
Lime	White	Hard	1170	1225			
Slate	Dark	Soft	1225	1250			
Lime	White	Hard	1250	1265			
Pgh. Coal	Black	Soft	1265	1272			
Slate	"	"	1272	1354			
Murphy Sand	White	Hard	1354	1400			
Slate	Dark	Soft	1400	1425			
Sand	White	Hard	1425	1450			
Red Rock	Red	Soft	1450	1500			
Slate	White	"	1500	1575			
Lime	"	Hard	1575	1612			
Sand	"	"	1612	1632			
Slate	"	Soft	1632	1665			
Little Dunkard	"	Hard	1665	1706			
Slate	"	Soft	1706	1738			
Big Dunkard	"	Hard	1738	1780			
Break	"	"	1780	1790			
2nd. Big Dunkard	"	Hard	1790	1826			
Slate	White	Soft	1826	1925			
Gas Sand	"	"	1925	1953			

9

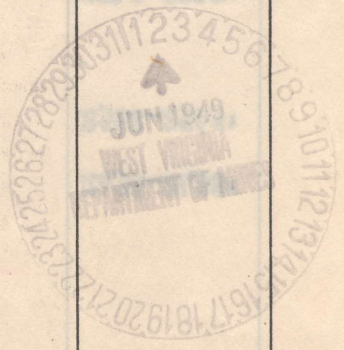

Formation	Color	Hard or Soft	Top	Bottom	Oil, Gas or Water	Depth Found	Remarks
Slate&Shells	White	Soft	1953	2030			
1st.Salt Sand	Dark	Hard	2030	2056			
Slate	"	Soft	2056	2066			
2nd.Salt Sand	White	Hard	2066	2157			
Slate&Shells	"	S.&.H.	2157	2397			
Maxon Sand	"	Hard	2397	2480	Gas	2436-2438'	
Big Lime	"		2480	2545			
Big Injun	Dark	Hard	2545	2732	Gas	2562-2565'	
Slate&Lime	D.&.W.	S.&.H.	2732	3100			
Sand	White	Hard	3100	3120			
Lime	"	"	3120	3208			
50 Ft.Sand	"	"	3208	3218	Gas	3210-3212'	
Slate	Dark	Soft	3218	3255			
30 Ft.Sand	White	Hard	3255	3280			
Slate	Dark	Soft	3280	3296			
Gordon Stray	White	Hard	3296	3320	Gas	3297-3298'	
Slate	"	Soft	3320	3327			
Gordon Sand	"	Hard	3327	3362			
Slate	"	Soft	3362	3385			
Sand	"	Hard	3385	3395			
Slate	"	Soft	3395	3397			
4th.Sand	"	Hard	3397	3450	Gas	3434-3436'	
Slate	Dark	Soft	3450	3470			
5th.Sand	"	Hard	3470	3500	Gas	3492-3494'	
Slate&Shells		H.&.S.	3500	3717			
Total depth.....				3717			

May 26, 1949

Date \_\_\_\_\_, 19\_\_\_\_

PITTSBURGH & WEST VA GAS COMPANY.

APPROVED

Owner

By

*W. M. [Signature]*

(Title)