


Latitude 39° 30'

Longitude 80° 20' +

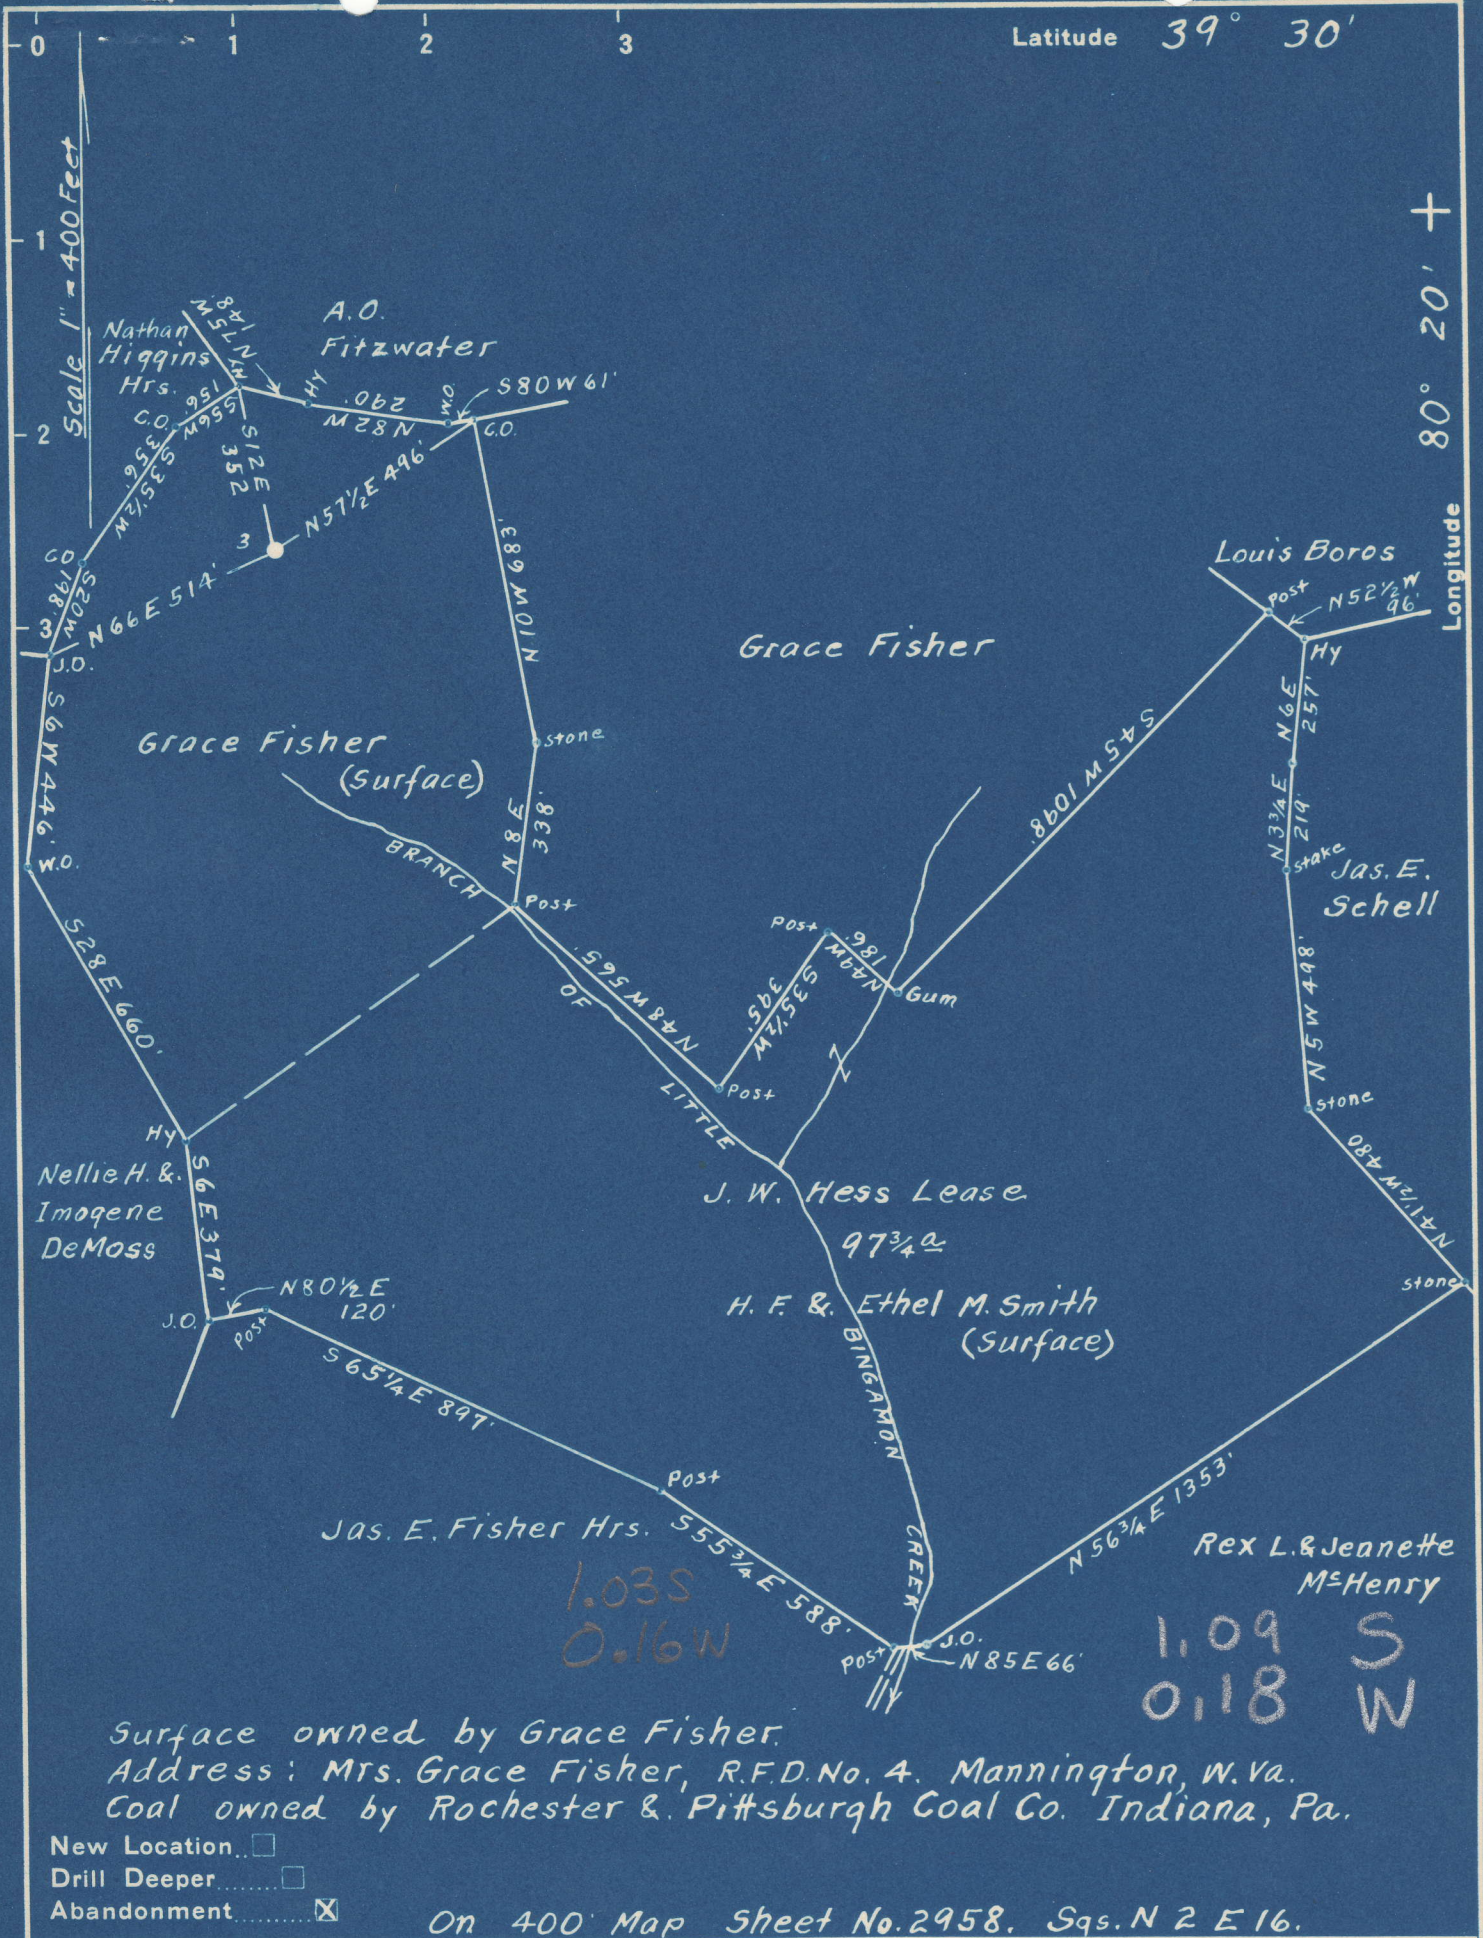

Surface owned by Grace Fisher.
 Address: Mrs. Grace Fisher, R.F.D. No. 4, Mannington, W. Va.
 Coal owned by Rochester & Pittsburgh Coal Co. Indiana, Pa.

- New Location..
- Drill Deeper.....
- Abandonment.....

On 400 Map Sheet No. 2958, Sqs. N 2 E 16.

Company Raad Supply Co.
 Address Salem, W. Va.
 Farm J. W. Hess
 Tract _____ Acres 97 3/4 Lease No. _____
 Well (Farm) No. 3. Serial No. _____
 Elevation (Spirit Level) Floor - 1466.33
Ground - 1463.83
 Quadrangle Clarksburg
 County Marion District Lincoln
 Engineer A. L. Headley
 Engineer's Registration No. 2021
 File No. _____ Drawing No. _____
 Date Mar. 30th, 1949. Scale 1" = 400 Feet

STATE OF WEST VIRGINIA
 DEPARTMENT OF MINES
 OIL AND GAS DIVISION
 CHARLESTON

WELL LOCATION MAP
 FILE NO. MAR-630-A

+ Denotes location of well on United States Topographic Maps, scale 1 to 62,500, latitude and longitude lines being represented by border lines as shown.

- Denotes one inch spaces on border line of original tracing.



STATE OF WEST VIRGINIA
DEPARTMENT OF MINES
OIL AND GAS DIVISION

Oil or Gas Well (KIND)

Ab 630A

718

Permit No. _____


Company Read Supply Company
Address 184 East Main St., Salem, W. Va.
Farm J. W. Hess Acres 97 3/4
Location (waters) Br. of Little Bingham Creek
Well No. 3 Elev. 1463.83
District Mannington County Marion
The surface of tract is owned in fee by Mrs. Grace Fisher
R. F. D. #4 Address Mannington, W. Va.
Mineral rights are owned by Rochester & Pittsburgh
Coal Co. Address Indiana, Pa.
Drilling commenced _____
Drilling completed January 18, 1908
Date Shot _____ From _____ To _____
With _____

Casing and Tubing	Used in Drilling	Left in Well	Packers
Size			Kind of Packer
16			
13			
10	233'	233'	Size of
8 1/4	1264'	1264'	Depth set
6 5/8	2103'	2103'	
5 3/16	2293'	2293'	
3			Perf. top
2	3001'	3001'	Perf. bottom
Liners Used			Perf. top
			Perf. bottom

Open Flow _____ /10ths Water in _____ Inch
_____ /10ths Merc. in _____ Inch
Volume _____ Cu. Ft.
Rock Pressure _____ lbs. _____ hrs.
Oil _____ bbls., 1st 24 hrs.
Fresh water _____ feet _____ feet
Salt water _____ feet _____ feet

CASING CEMENTED No SIZE _____ No. Ft. _____ Date _____
COAL WAS ENCOUNTERED AT 669 FEET 84 INCHES
770 FEET 60 INCHES
FEET INCHES FEET INCHES

Formation	Color	Hard or Soft	Top	Bottom	Oil, Gas or Water	Depth Found	Remarks
Conductor				16'			
Mapletown Coal			665'	669			
Pittsburgh Coal			765	770			
Little Dunkard			1065	1090			
Big Dunkard			1175	1275			
Salt Sand			1550	1670			
Little Lime			2046	2066			
Pencil Cave			2066	2074			
Big Lime			2074	2149			
Big Injun			2149	2280			
Gas			2169		Gas		
Stray Sand			2951	2971			
Gordon			2976				
1st Pay			2982				
Total Depth				3001			

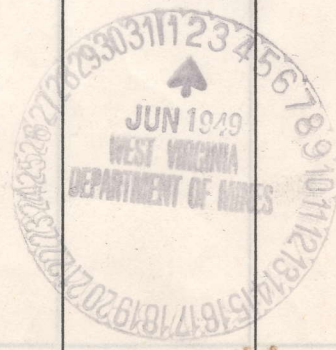

JAN 20 1950

