

#6802	2.42	S
	1.68	W
#5611	2.37	S
	1.82	W
#1992	2.28	S
	1.90	W

Map Sh. 27 Sq. N-7 E-23 Bk. 639 - P. 5-6

Company HOPE NATURAL GAS Co.  
 Address CLARKSBURG W.Va.  
 Farm Enoch H. Amos  
 Tract 1 Acres 145 Lease No. 10528  
 Well (Farm) No. 2 Serial No. 5611  
 Elevation (Spirit Level) 1333. As Shown  
 Quadrangle BLACKSVILLE, W.Va. - Pa.  
 County MARION District PAW PAW  
 Engineer S.H. Bradley  
 Engineer's Registration No. 135  
 File No. \_\_\_\_\_ Drawing No. \_\_\_\_\_  
 Date 12-16-36 Scale 1" = 40 Pole

STATE OF WEST VIRGINIA  
 DEPARTMENT OF MINES  
 OIL AND GAS DIVISION  
 CHARLESTON

**WELL LOCATION MAP**  
 FILE NO. MAR-157-A  
MAR-694A #6802

+ Denotes location of well on United States Topographic Maps, scale 1 to 62,500, latitude and longitude lines being represented by border lines as shown.

- Denotes one inch spaces on border line of original tracing.



STATE OF WEST VIRGINIA  
DEPARTMENT OF MINES  
OIL AND GAS DIVISION

723

644-A

WELL RECORD

Permit No. \_\_\_\_\_ Oil or Gas Well \_\_\_\_\_ (KIND)


Company Hope Natural Gas Company.  
Address 445 West Main St. Clarksburg, W. Va.  
Farm Enoch H. Amos Acres 145  
Location (waters) \_\_\_\_\_  
Well No. 6802 Elev. 1333  
District Paw Paw County Marion  
The surface of tract is owned in fee by \_\_\_\_\_  
Address \_\_\_\_\_  
Mineral rights are owned by \_\_\_\_\_  
Address \_\_\_\_\_  
Drilling commenced July 8, 1926  
Drilling completed September 8, 1926  
Date Shot \_\_\_\_\_ From \_\_\_\_\_ To \_\_\_\_\_  
With \_\_\_\_\_

Casing and Tubing	Used in Drilling	Left in Well	Packers
Size			
16			Kind of Packer
13			
10	647	647	Size of
8 1/4	1395	1395	
6 5/8	1475	1475	Depth set
5 3/16	1895	1895	
3			Perf. top
2			Perf. bottom
Liners Used			Perf. top
			Perf. bottom

Open Flow \_\_\_\_\_ /10ths Water in \_\_\_\_\_ Inch  
\_\_\_\_\_ /10ths Merc. in \_\_\_\_\_ Inch  
Volume \_\_\_\_\_ Cu. Ft.  
Rock Pressure \_\_\_\_\_ lbs. \_\_\_\_\_ hrs.  
Oil \_\_\_\_\_ bbls., 1st 24 hrs.  
Fresh water 1490 feet \_\_\_\_\_ feet  
Salt water none recorded feet \_\_\_\_\_ feet

CASING CEMENTED 10" SIZE 647 No. Ft. July, 1926 Date  
COAL WAS ENCOUNTERED AT 453 FEET 60 INCHES  
572 FEET 108 INCHES FEET INCHES  
FEET INCHES FEET INCHES

Formation	Color	Hard or Soft	Top	Bottom	Oil, Gas or Water	Depth Found	Remarks
Mapletown Coal			453	458			
Pittsburgh Coal			572	581			
Gas sand			1247	1296	gas	1287	
First Salt			1377	1420			
Second Salt			1465	1574	water	1490	
Little Lime			1787	1800			
Pencil cave			1800	1805			
Big Lime			1805	1915			
Big Injun			1915	2024	gas	1940 1996	
Total depth				2024			

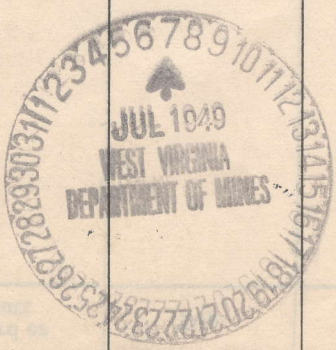

70758

