


Latitude 39° 40'

Longitude 80° 10'

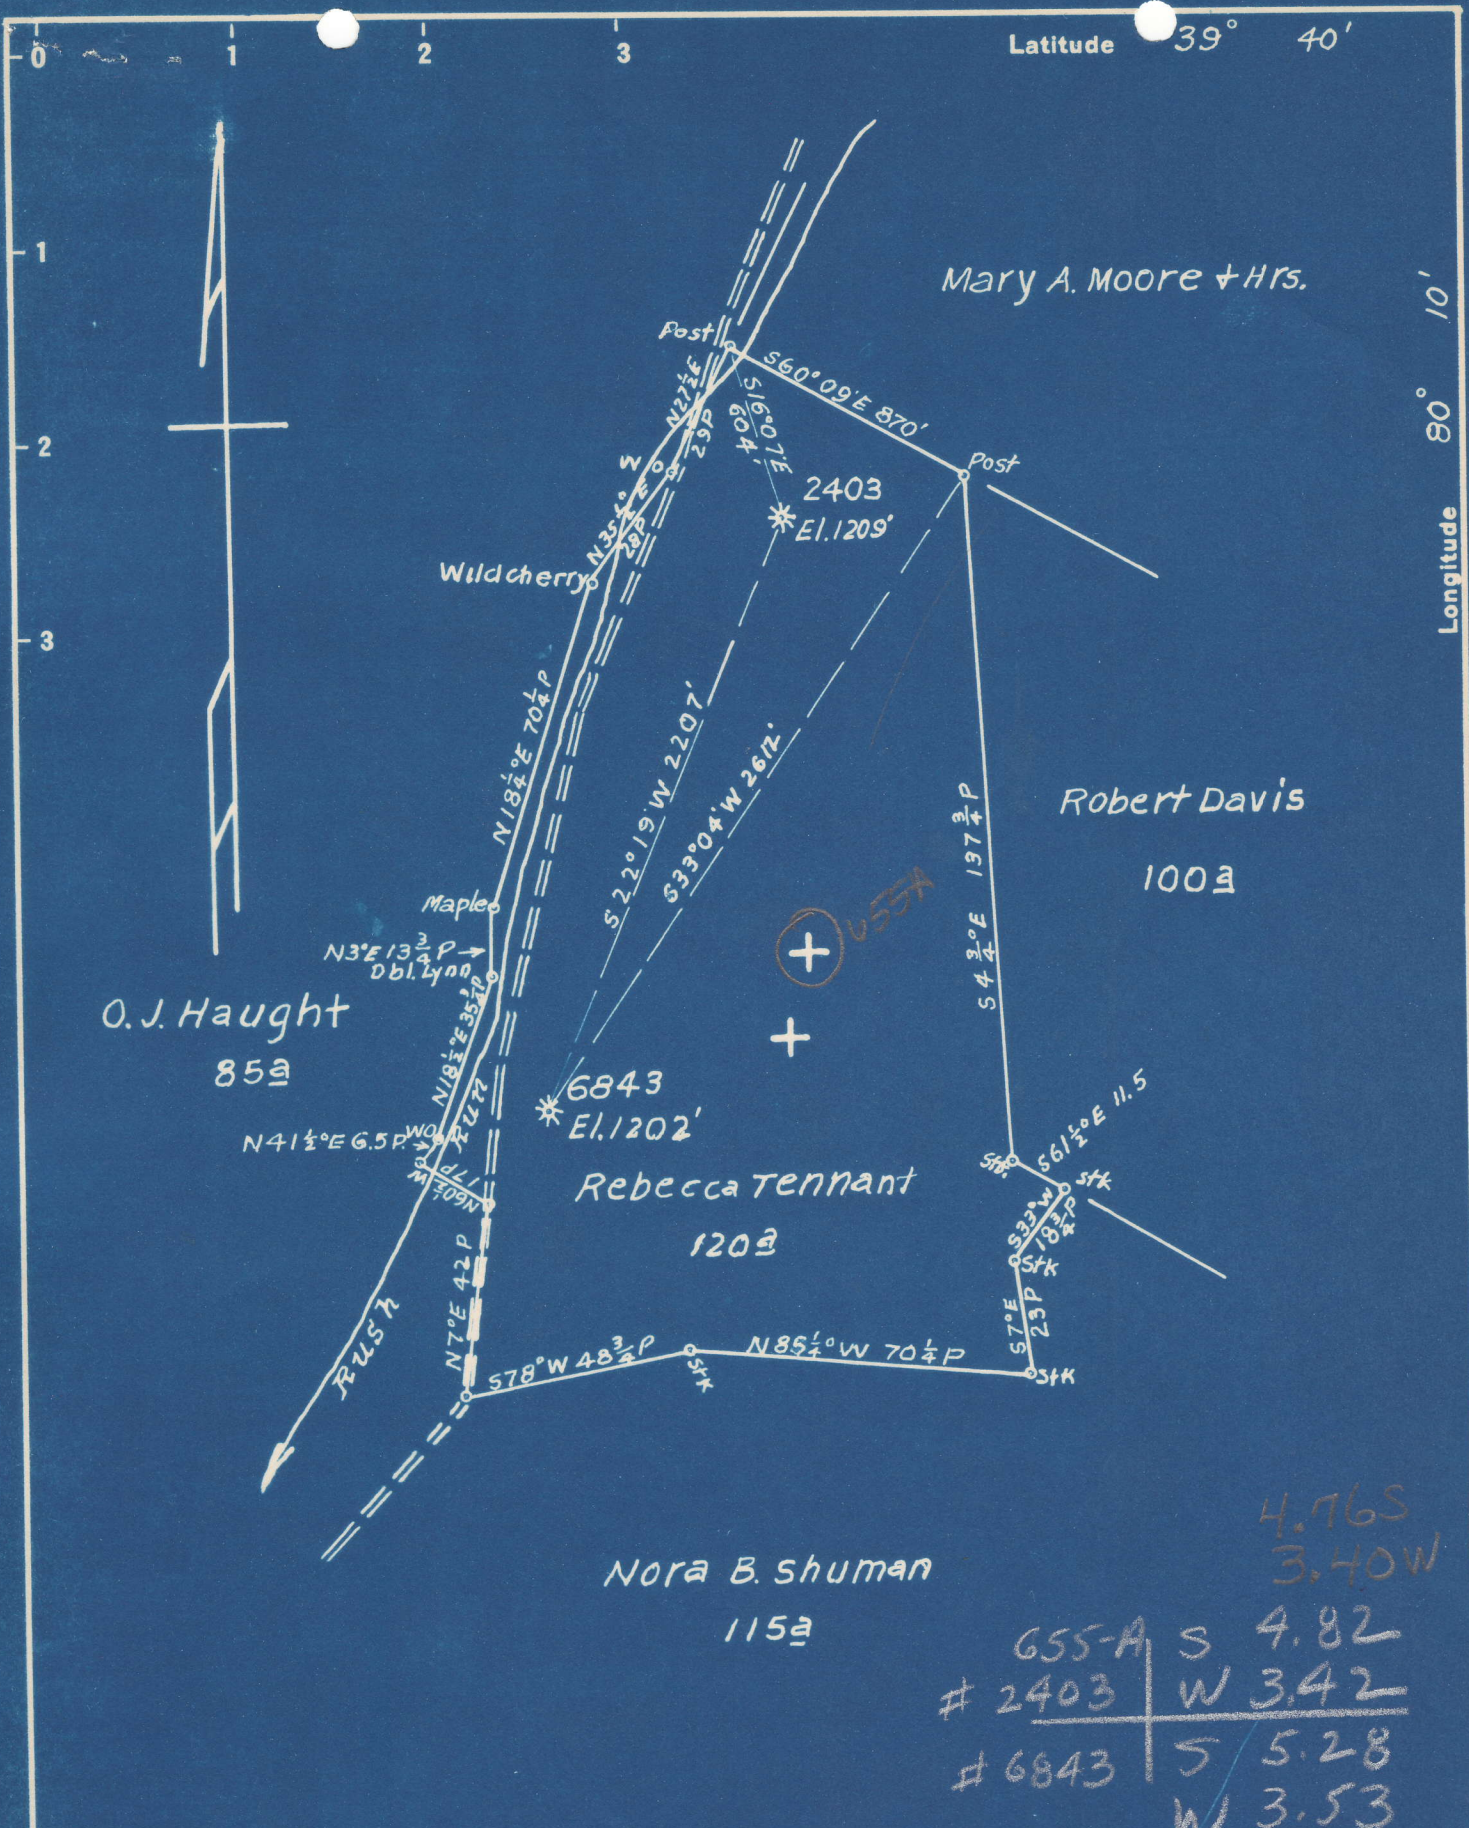

	S	4.76S
	W	3.40W
# 2403	S	4.82
	W	3.42
# 6843	S	5.28
	W	3.53

New Location...
 Drill Deeper.....
 Abandonment..... 2403

Mapsh 27 N10E22 FB946 R13-14.

Company Hope Natural Gas Co
 Address Clarksburg, Wva
 Farm Rebecca Tennant
 Tract _____ Acres 120 Lease No 20671
 Well (Farm) No. _____ Serial No. As Shown
 Elevation (Spirit Level) As Shown
 Quadrangle Blacksville
 County Marion District Paw Paw
 Engineer W M Bower
 Engineer's Registration No. 900 WC
 File No. _____ Drawing No. _____
 Date 11-28-49 Scale 1" = 40P

STATE OF WEST VIRGINIA
 DEPARTMENT OF MINES
 OIL AND GAS DIVISION
 CHARLESTON

WELL LOCATION MAP
 FILE NO. MAR-655-A-# 2403

+ Denotes location of well on United States Topographic Maps, scale 1 to 62,500, latitude and longitude lines being represented by border lines as shown.

- Denotes one inch spaces on border line of original tracing.

REBECCA TRINHART NO. 2403 WELL.

655A

Prager District, Marion County, W. Va.
 By Hope Natural Gas Co., 445 W. Main St., Clarksburg, W. Va.
 Abandoned under permit Nos.-A7
 On 120 acres.

Elevation, 1267' L. 1209

Drilling commenced Jan. 1, 1912; completed Jan. 29, 1912.

No water recorded.

10" casing, 530'; 8 1/2" casing, 1233'; 3" tubing, 1252'; all left in.

10" casing cemented, 530', in 1912.

Coal was encountered at 75-80, 375-380, and 465-471'.

Gas well. Record to Dept. of Mines dated Nov. 25, 1949.

Record to RUT from Mrs. Griffith March 6, 1950. Old File No. 739.

	Top.	Bottom.
Native coal	75	80
Mapletown (Sedickley) coal	375	380
Pittsburgh coal	465	471
Little Dunkard Sand	890	910
Big Dunkard Sand	995	1025
Gas Sand (gas, 1222')	1180	1252
Total depth		1252



STATE OF WEST VIRGINIA
DEPARTMENT OF MINES
OIL AND GAS DIVISION

739

WELL RECORD

Permit No. MAR-655-A

Oil or Gas Well _____
(KIND)


Company Hope Natural Gas Company.
Address 445 West Main St. Clarksburg, W. Va.
Farm Rebecca Tennant Acres 120
Location (waters) _____
Well No. 2403 Elev. 1264
District Paw Paw County Marion 1209
The surface of tract is owned in fee by _____
Address _____
Mineral rights are owned by _____
Address _____
Drilling commenced January 1, 1912
Drilling completed January 29, 1912
Date Shot _____ From _____ To _____
With _____
Open Flow _____ /10ths Water in _____ Inch
_____ /10ths Merc. in _____ Inch
Volume _____ Cu. Ft.
Rock Pressure _____ lbs. _____ hrs.
Oil _____ bbls., 1st 24 hrs.
Fresh water none recorded feet _____ feet
Salt water none recorded feet _____ feet

Casing and Tubing	Used in Drilling	Left in Well	Packers
Size			Kind of Packer
16			
13			
10	530	530	Size of
8 1/4	1233	1233	
6 3/8			Depth set
5 3/16			
3	1252	1252	Perf. top
2			Perf. bottom
Liners Used			Perf. top
			Perf. bottom

CASING CEMENTED 10 SIZE 530 No. Ft. 1912 Date _____

COAL WAS ENCOUNTERED AT 75 FEET 60 INCHES
375 FEET 60 INCHES 465 FEET 72 INCHES
_____ FEET _____ INCHES _____ FEET _____ INCHES

Formation	Color	Hard or Soft	Top	Bottom	Oil, Gas or Water	Depth Found	Remarks
Native coal			75	80			
Mapletown			375	380			
Pittsburgh Coal			465	471			
Little Dunkard			890	910			
Big Dunkard			995	1025			
Gas Sand			1180	1252	gas	1222	
Total depth				1252			

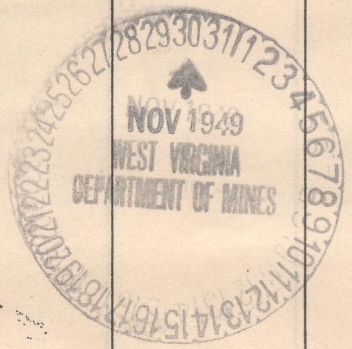

MAR 6 1950

