

NOTE:- The Snyder & Metz Lease - formerly owned by Malinda Metz, and the Frank S. Snyder Lease are now a part of that tract owned by Jerry Osborn Bland and Martha Violet Bland, whose postoffice address is Route No. 1, Mannington, West Va.

- New Location
- Drill Deeper
- Abandonment

Company **INTERSTATE PIPE & SUPPLY CO.**
 Address Fourth and Church Sts., Marietta, Ohio.
 Farm Frank S. Snyder and Snyder & Metz Leases
 Tract _____ Acres 133 Lease No. _____
 Well (Farm) No. 1, 2, 3 and 4 Serial No. _____
 Elevation (Spirit Level) No. 1 - 1170, No. 2 - 1240, No. 3 - 1135, No. 4 -
 Quadrangle Mannington (410)
 County Marion District Mannington
 Engineer Mark A. [Signature]
 Engineer's Registration No. 1227
 File No. _____ Drawing No. _____
 Date September, 1950 Scale 1" = 500'

STATE OF WEST VIRGINIA
 DEPARTMENT OF MINES
 OIL AND GAS DIVISION
 CHARLESTON

WELL LOCATION MAP
 MAR - 677-A - #2
 FILE NO. MAR - 678-A - #1 - no 208
 MAR - 679-A #1 - su-4
 MAR - 680-A - #3

+ Denotes location of well on United States Topographic Maps, scale 1 to 62,500, latitude and longitude lines being represented by border lines as shown.

- Denotes one inch spaces on border line of original tracing.



STATE OF WEST VIRGINIA
DEPARTMENT OF MINES
OIL AND GAS DIVISION

760

WELL RECORD

Permit No. 1144-680-08


Oil or Gas Well X (KIND)

Company The Interstate Pipe & Supply Company
Address P. O. Box 548, Marietta, Ohio
Farm Frank Snyder Acres 132
Location (waters) Hibbs Run
Well No. 3 Elev. 1135
District Narrington County Marion
The surface of tract is owned in fee by Jerry & Martha Eland
Route 1 Address Narrington, W. Va.
Mineral rights are owned by The Charleston National Bank,
Trustee, c/o Bernard C. Sampson Company
Box 368, Fairmont, West Virginia
Drilling commenced _____
Drilling completed _____
Date Shot _____ From _____ To _____
With _____
Open Flow _____ /10ths Water in _____ Inch
_____ /10ths Merc. in _____ Inch
Volume _____ Cu. Ft.
Rock Pressure _____ lbs. _____ hrs.
Oil _____ bbls., 1st 24 hrs.
Fresh water _____ feet _____ feet
Salt water _____ feet _____ feet

Casing and Tubing	Used in Drilling	Left in Well	Packers
Size			Kind of Packer
16			
13			
10	225	none	Size of
8 1/4	1553	1553	
6 1/2	2395	2395	Depth set
5 3/16			
3			Perf. top
2			Perf. bottom
Liners Used			Perf. top
			Perf. bottom

CASING CEMENTED _____ SIZE _____ No. Ft. _____ Date _____
COAL WAS ENCOUNTERED AT 960 FEET 60 INCHES
1067 FEET 96 INCHES FEET INCHES
FEET INCHES FEET INCHES

Formation	Color	Hard or Soft	Top	Bottom	Oil, Gas or Water	Depth Found	Remarks
Conductor				10			
Mapletown Coal			960	965			
Pittsburgh Coal			1067	1075			
Little Dunkard Sand			1470	1490			
Big Dunkard Sand			1552	1562			
First Salt Sand			1750	1835			
Second Salt Sand			1855	1885			
Third Salt Sand			2040	2127			
Little Lime			2295	2310			
Pencil Cave			2310	2314			
Big Lime			2314	2366			
Big Injun Sand			2366				
Gas and Water				2370			
Oil and Gas			2480	2485			
Total Depth				2506			

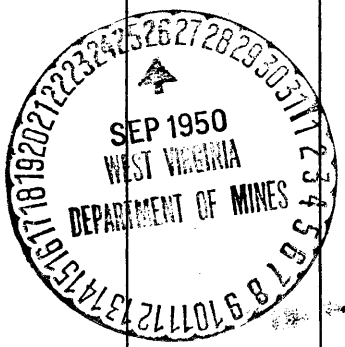

Formation	Color	Hard or Soft	Top	Bottom	Oil, Gas or Water	Depth Found	Remarks

Date September 13, 1929

APPROVED THE INDEPENDENT PIPE & SUPPLY COMPANY Owner

By Adolph Beren
(Title) a.