

Latitude 39° 30'

Longitude 80° 25'



surface owned by Jesse Talkington Hrs.  
 Address: Mr. L.B. Talkington, 543. Buffalo St. Mannington, W. Va.  
 Coal owned by Paul J. Sesler.  
 Address: Mr. Paul J. Sesler, P.O. Box No. 169. % Stewart McReynolds  
 Clarksburg, W. Va.

- New Location..
- Drill Deeper.....
- Abandonment.....

On 800' Map Sqs. N 2 E 10.

Company F.G. Bish  
 Address P.O. Box No. 428. Clarksburg, W. Va.  
 Farm Talkington Heirs  
 Tract \_\_\_\_\_ Acres 113 Lease No. \_\_\_\_\_  
 Well (Farm) No. 1. Serial No. \_\_\_\_\_  
 Elevation (Spirit Level) Floor - 1124.09  
Ground - 1122.39  
 Quadrangle Clarksburg  
 County Marion District Mannington  
 Engineer A.L. Headley,  
 Engineer's Registration No. 2021  NW  
 File No. \_\_\_\_\_ Drawing No. \_\_\_\_\_  
 Date Oct. 19th, 1949. Scale 1" = 400 Feet

STATE OF WEST VIRGINIA  
 DEPARTMENT OF MINES  
 OIL AND GAS DIVISION  
 CHARLESTON

**WELL LOCATION MAP**  
 FILE NO. MAR-681-A

- + Denotes location of well on United States Topographic Maps, scale 1 to 62,500, latitude and longitude lines being represented by border lines as shown.
- Denotes one inch spaces on border line of original tracing.

Mannington District, Marion County, W. Va.

By F. G. Bish, Box 428, Clarksburg, W. Va.

Abandoned under permit Mar-.....-A1

On 131 acres, on Bingson Creek.

Elevation, .....<sup>1</sup> L.

Surface owned by Talkington Heirs, R. H. Talkington, Agent,  
Wallace, W. Va., and coal by Sisler Heirs, Albert Sisler,  
Uniontown, Pa., and gas by Talkington Heirs.

Drilling completed in 1913.

Open flow, 42/10ths W. in 6<sup>3</sup>/<sub>4</sub>".

Volume, 3,000,000 cu. ft.

Rock pressure, no record.

Oil, 1 bbl.

10" casing, 200'; 8<sup>1</sup>/<sub>2</sub>", 1277'; 6<sup>3</sup>/<sub>4</sub>", 2000'; 5<sup>1</sup>/<sub>2</sub>", 2700'; 2" tubing,  
2790'; liner, 160'; all left in.

Packer set at 2700'.

Coal was encountered at 780-785'.

Gas-Oil well. Record to Dept. of Mines dated Oct. 3, 1950.

Record to RCT from Mrs. Griffith June 28, 1951. Old File No. 798.

	Top.	Bottom.
Pittsburgh Coal	780	- 785
Sand, Little Dunkard	1160	- 1165
Big Dunkard Sand	1265	- 1280
Gas Sand	1450	- 1500
Salt Sand	1720	- 1775
Little Lime	1995	- 2005
Big Lime	2025	- 2090
Big Injun Sand	2090	- 2212
Fifty-foot Sand (gas, 2731')	2702	- 2740
Produced for some years as gas well; afterwards drilled deeper:		
Thirty-foot Sand (oil, 2785')	2766	- 2789
Total depth (after shot)		2790



STATE OF WEST VIRGINIA  
DEPARTMENT OF MINES  
OIL AND GAS DIVISION

798

WELL RECORD

Permit No. 681-A


Oil or Gas Well Gas-Oil  
(KIND)

Company F.C. Bish  
Address Box 428 Clarksburg West Va  
Farm Jesse Talkington Hrs Acres 131  
Location (waters) Bingamon Creek  
Well No. one Elev. \_\_\_\_\_  
District Mannington County Marion  
The surface of tract is owned in fee by Talkington Hrs  
R H Talkington Agt Address Wallace W Va  
Mineral rights are owned by Coal - Sisler Hrs  
Albert Sisler Address Uniontown Pa  
Drilling commenced \_\_\_\_\_  
Drilling completed 1913  
Date Shot \_\_\_\_\_ From \_\_\_\_\_ To \_\_\_\_\_  
With \_\_\_\_\_  
Open Flow 42 /10ths Water in \_\_\_\_\_ Inch  
8 mill /10ths Merc. in \_\_\_\_\_ Inch  
Volume \_\_\_\_\_ Cu. Ft.  
Rock Pressure No record lbs. \_\_\_\_\_ hrs.  
Oil 1 bbl bbls., 1st 24 hrs.  
Fresh water \_\_\_\_\_ feet \_\_\_\_\_ feet  
Salt water \_\_\_\_\_ feet \_\_\_\_\_ feet

Casing and Tubing	Used in Drilling	Left in Well	Packers
Size			
16			Kind of Packer
13			<u>2700</u>
10	<u>200</u>	<u>200</u>	Size of
8 1/4	<u>1277</u>	<u>1277</u>	Depth set
6 5/8	<u>2000</u>	<u>2000</u>	
5 3/16	<u>2700</u>	<u>2700</u>	
3			Perf. top
2	<u>2790</u>	<u>2790</u>	Perf. bottom
Liners Used	<u>160</u>	<u>160</u>	Perf. top
			Perf. bottom

CASING CEMENTED \_\_\_\_\_ SIZE \_\_\_\_\_ No. Ft. \_\_\_\_\_ Date \_\_\_\_\_  
Pittsburg  
COAL WAS ENCOUNTERED AT 780 FEET 60" INCHES  
FEET INCHES FEET INCHES  
FEET INCHES FEET INCHES

Formation	Color	Hard or Soft	Top	Bottom	Oil, Gas or Water	Depth Found	Remarks
Coal	<u>Pittsburg</u>		<u>780</u>	<u>785</u>			
Sand	<u>Little Dunkard</u>		<u>1160</u>	<u>1165</u>			
Big Dunkard Sand			<u>1265</u>	<u>1280</u>			
Gas Sand			<u>1450</u>	<u>1500</u>			
Salt Sand			<u>1720</u>	<u>1775</u>			
<del>Salt Sand</del>							
Little Lime			<u>1905</u>	<u>2005</u>			
Big Lime			<u>2025</u>	<u>2090</u>			
Big Injun Sand			<u>2090</u>	<u>2212</u>			
50 ft Sand			<u>2702</u>	<u>2740</u>	<u>Gas 2731</u>		
Produced for some years as gas well							
afterward drilled deeper							
30 ft Sand			<u>2766</u>	<u>2789</u>	<u>Oil 2785</u>		
Total Depth after shot				<u>2790</u>			

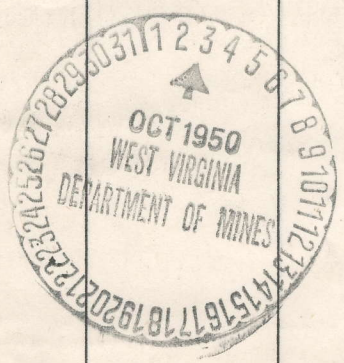

JUN 28 1951

