

Surface owned by Ray Lemley.
 Address: Mr. Ray Lemley, R.F.D. No. 2, Fairview, W. Va.
 Coal owned by J. Harper Meredith.
 Address: Mr. J. Harper Meredith, P.O. Box No. 166, Fairmont, W. Va.

New Location
 Drill Deeper
 Abandonment On 400' Map No. 2758. 598. N 6 E 16.

Company William Moses
 Address Salem, W. Va.
 Farm F. D. Watson
 Area 85 Lease No. _____

STATE OF WEST VIRGINIA
 DEPARTMENT OF MINES
 OIL AND GAS DIVISION
 CHARLESTON

WELL LOCATION MAP



STATE OF WEST VIRGINIA
DEPARTMENT OF MINES
OIL AND GAS DIVISION

824

WELL RECORD

Permit No. MAR-693-A

Oil or Gas Well _____
(KIND)

Company <u>Wm. Moses</u>	Casing and Tubing	Used in Drilling	Left in Well	Packers
Address <u>Salem, W. Va.</u>	Size			
Farm <u>F.D. Watson</u> Acres _____	16			Kind of Packer
Location (waters) _____	13			
Well No. <u>2</u> Elev. _____	10		<u>180</u>	Size of _____
District <u>Hannington</u> County <u>Marion</u>	8 1/4		<u>1621</u>	Depth set
The surface of tract is owned in fee by _____	6 5/8		<u>2005.</u>	
Address _____	5 3/16			Perf. top
Mineral rights are owned by _____	3			Perf. bottom
Address _____	2			Perf. top
Drilling commenced _____	Liners Used			Perf. bottom
Drilling completed <u>No record available.</u>				
Date Shot _____ From _____ To _____				
With _____				
Open Flow _____ /10ths Water in _____ Inch				
_____ /10ths Merc. in _____ Inch				
Volume _____ Cu. Ft.				
Rock Pressure _____ lbs. _____ hrs.				
Oil _____ bbls., 1st 24 hrs.				
Fresh water _____ feet _____ feet				
Salt water _____ feet _____ feet				


CASING CEMENTED _____ SIZE _____ No. Ft. _____ Date _____

COAL WAS ENCOUNTERED AT 642 FEET 84 INCHES

_____ FEET _____ INCHES FEET _____ INCHES

_____ FEET _____ INCHES FEET _____ INCHES

Formation	Color	Hard or Soft	Top	Bottom	Oil, Gas or Water	Depth Found	Remarks
Pgh Coal			642	649			
Salt			1550 1550	1710 1710			
Big Lime			1900	1956			
" Injun			1956	2067			
Total Depth				2088			

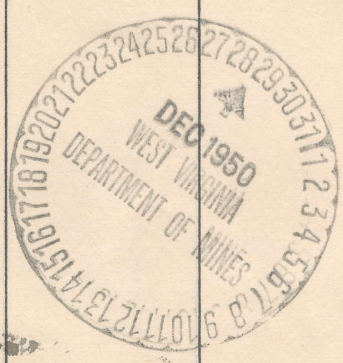

824