

New Location
 Dry Deeper
 Abandonment

MAP SHT. 16 N9E25 EB. 906 P. 30


Company HOPE NATURAL GAS CO.
 Address CLARKSBURG W.VA.
 Name JOHN M. AMMONS
 Acres 225 Lease No. 61210

STATE OF WEST VIRGINIA
 DEPARTMENT OF MINES
 OIL AND GAS DIVISION
 CHARLESTON

WELL LOCATION MAP

LATITUDE 39 37 30

LONGITUDE 85 07 30

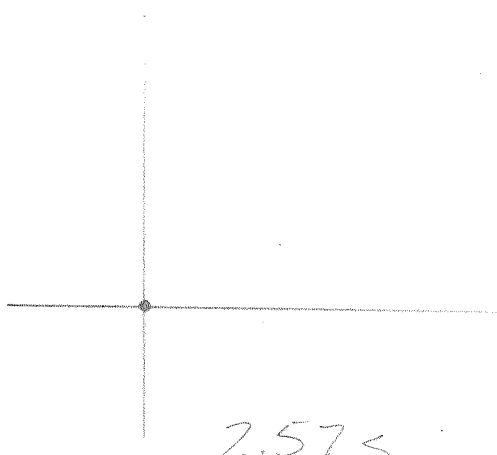

2.57 S

1.97 W

7'5 OGIS topo location

7.5' loc _____

15' loc _____
(calc.)

Company _____ 9610

Farm JOHN H. AMMONS

Quad Grant Town

County Marion

District Few Paw

WELL LOCATION MAP

File No. 30703

7032

Parson District, Marion County, W. Va.
 By Hope Natural Gas Co., 445 W. Main St., Clarksburg, W. Va.
 abandoned under permit No.
 on 225 acres.

Elevation, 1019' L.

Drilling commenced March 3, 1915; completed April 3, 1915.

No fresh water recorded.

Salt water at 1235'.

10" casing, 300' (pulled); 8", 1262' (pulled); 6", 1603'; 5", 1616'.

Casing not cemented.

Coal was encountered at 224-230 and 305-307'.

Gas well. Record to Dept. of Mines dated March 13, 1951.

Record to RRT from Mrs. Griffith June 28, 1951. Old File No. 786.

	Top.	Bottom.
Hopkinton (Sewickley) Coal	224	230
Pittsburgh Coal	305	307
Little Harbord Sand	702	729
Gas Sand	1175	1220
Salt Sand (hole full water, 1235')	1225	1340
Big Linc	1563	1540
Big Injun Sand (gas, 1653 and 1741')	1640	1785
Total depth		1785



STATE OF WEST VIRGINIA
DEPARTMENT OF MINES
OIL AND GAS DIVISION

786

WELL RECORD

Permit No. MAR-703-A

Oil or Gas Well
(KIND)

Company Hope Natural Gas Company,
 Address 445 West Main St. Clarksburg, W. Va.
 Farm John H. Ammons Acres 225
 Location (waters) _____
 Well No. 9610 Elev. 1019
 District Raw Paw County Marion
 The surface of tract is owned in fee by _____
 Address _____
 Mineral rights are owned by _____
 Address _____
 Drilling commenced March 3, 1915
 Drilling completed April 3, 1915
 Date Shot _____ From _____ To _____
 With _____
 Open Flow _____ /10ths Water in _____ Inch
 _____ /10ths Merc. in _____ Inch
 Volume _____ Cu. Ft.
 Rock Pressure _____ lbs. _____ hrs.
 Oil _____ bbls., 1st 24 hrs.
 Fresh water none recorded feet _____ feet
 Salt water 1235 feet _____ feet

Casing and Tubing	Used in Drilling	Left in Well	Packers
Size			Kind of Packer
16			
13			
10	360	Pulled	Size of
8 1/4	1262	Pulled	
6 5/8	1603	1603	Depth set
5 3/16	1616	1616	
3			Perf. top
2			Perf. bottom
Liners Used			Perf. top
			Perf. bottom

CASING CEMENTED NOT SIZE _____ No. Ft. _____ Date _____
 COAL WAS ENCOUNTERED AT 224 FEET 72 INCHES
305 FEET 24 INCHES FEET INCHES
 FEET INCHES FEET INCHES

Formation	Color	Hard or Soft	Top	Bottom	Oil, Gas or Water	Depth Found	Remarks
Mapletown Coal			224	230			
Pittsburgh Coal			305	307			
Little Dunkard Gas sand			702	729			
			1175	1220			
Salt sand			1225	1340	hole full water	1235	
Big Lime			1563	1640			
Big Injun			1640	1785	gas	1650 84 1741	
Total depth				1785			

