

Surface owned by Evelyn Morgan Cutlip.
 Address: Mrs. Evelyn Morgan Cutlip, 800 No. 1 Fairington Ave.
 Coal owned by The Charleston National Bank, Trustee
 Address: Bernard G. Sampson, Esq., P.O. Box No 368 Fairmont, W. Va.

New Location
 Drill Deeper
 Abandonment UN 800 Map NS1E 221 N 9 E 17


Company Reed Supply Co.
 Address Salem, W. Va.
 Farm C. D. Morgan
 Tract Acres 100 Lease No. _____

STATE OF WEST VIRGINIA
 DEPARTMENT OF MINES
 OIL AND GAS DIVISION
 CHARLESTON

WELL LOCATION MAP

LATITUDE 39 32 30

LONGITUDE 80 17 30

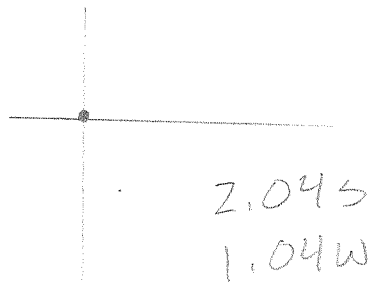

7'5 OGIS topo location

7.5' loc _____ 15' loc _____
 _____ (calc.) _____

Company _____

Farm C D MORGAN 7

Quad MANNINGTON

County MARION

District LINCOLN

WELL LOCATION MAP

File No. 30715

C. D. MORGAN NO. 7 WELL.

Lincoln District, Marion County, W. Va.
 By Reed Supply Co., 124 N. Main St., Shen, W. Va.
 Abandoned under permit No.-47
 On 100 acres.

Elevation, l.
 Drilling completed April 30, 1908.
 8" casing, 1143'; 6", 1963'; 5", 2184'; 2" tubing, 2901';
 4 1/2" liner, 339'; all left in.

Casing not cemented.
 Coal was encountered at 530-534 and 642-647'.
 Oil well. Record to Dept. of Mines stamped April 27, 1951.
 Record to ROT from Mrs. Griffith Aug. 17, 1951. Old File No. 805.

	Top.	Bottom.
Mapletown (Sewickley) Coal	530	534
Pittsburgh Coal	642	647
Munkard Sand	1125	1135
Gas Sand	1365	1430
Big lime	1935	1996
Big Injun Sand (gas, 1996') (gas, 2090')	1996	2110
Fifty-foot Sand	2550	2640
Stray Sand	2830	2850
Gordon Sand (break, 2890-2895') (1st pay, 2875'; 2nd pay, 2888')	2861
Total depth		2901



STATE OF WEST VIRGINIA
DEPARTMENT OF MINES
OIL AND GAS DIVISION

805

WELL RECORD

Permit No. MAR-715-A

Oil or Gas Well _____
(KIND)

Company Raad Supply Company
Address 184 East Main St., Salem, W. Va.
Farm C. D. Morgan Acres 100
Location (waters) _____
Well No. 7 Elev. _____
District Lincoln County Marion
The surface of tract is owned in fee by _____
Address _____
Mineral rights are owned by _____
Address _____
Drilling commenced _____
Drilling completed April 30, 1908
Date Shot _____ From _____ To _____
With _____
Open Flow _____ /10ths Water in _____ Inch
_____ /10ths Merc. in _____ Inch
Volume _____ Cu. Ft.
Rock Pressure _____ lbs. _____ hrs.
Oil _____ bbls., 1st 24 hrs.
Fresh water _____ feet _____ feet
Salt water _____ feet _____ feet

Casing and Tubing	Used in Drilling	Left in Well	Packers
Size			
16			Kind of Packer
13			
10			Size of
8 1/4	1143'	1143'	
6 3/4	1968'	1968'	Depth set
5 3/16	2184'	2184'	
3			Perf. top
2	2901'	2901'	Perf. bottom
Liners Used			Perf. top
4 1/2" x 4"	338'	338'	Perf. bottom

CASING CEMENTED No SIZE _____ No. Ft. _____ Date _____
COAL WAS ENCOUNTERED AT 543 FEET 48 INCHES
647 FEET 72 INCHES FEET INCHES
FEET INCHES FEET INCHES

Formation	Color	Hard or Soft	Top	Bottom	Oil, Gas or Water	Depth Found	Remarks
Mapletown Coal			530'	534'			
Pittsburgh Coal			641	647			
Dunkard Sand			1125	1135			
Gas, Sand			1365	1430			
Big Lime			1935	1996			
Big Injun Sand			1996	2110			
Gas			1996		Gas		
Gas			2090		Gas		
Fifty Foot Sand			2550	2640			
Stray Sand			2830	2850			
Gordon Sand			2861				
Brake in Gordon			2890	2895			
1st Pay			2875				
2nd Pay			2888				
Total Depth				2901			

