

Surface owned by J.N. Allen.
 Address: Mr. J.N. Allen, R.F.D. No. 1, Smithfield, W. Va.
 Coal owned by The Charleston National Bank, Trustee.
 Address: Bernard G. Sampson, Engr. P.O. Box No. 368, Fairmont, W. Va.

New Location
 Drill Deeper
 Abandonment On 800' Map N50E, S91, N6 E11.

Company Menley, Beatty & Beatty.
 Address 429 Clarksburg St. Mannington, W. Va.
 Farm Hawkins-Shodgrass
 Tract Acres 119 1/2 Lease No.

STATE OF WEST VIRGINIA
 DEPARTMENT OF MINES
 OIL AND GAS DIVISION
 CHARLESTON
 WELL LOCATION MAP



STATE OF WEST VIRGINIA
DEPARTMENT OF MINES
OIL AND GAS DIVISION

813

WELL RECORD

Oil

Oil or Gas Well (KIND)

Permit No. MAR-726-A


Company Hanley, Beaty and Beaty.
Address Hammington, W. Va.
Farm Hawkins - Snodgrass. Acres 119 1/4
Location (waters) Bartholomew.
Well No. 1. Elev. 1168.19
District Hammington. County Marion.
The surface of tract is owned in fee by J. N. Allen.
R.F.D. No 1. Address Smithfield, W. Va.
Mineral rights are owned by The Charleston National Bank,
Trustee, P.O. Box 368. Address Fairmont, W. Va.

Drilling commenced _____
Drilling completed Oct, 9th, 1916.
Date Shot _____ From _____ To _____
With _____
Open Flow _____ /10ths Water in _____ Inch
_____ /10ths Merc. in _____ Inch
Volume _____ Cu. Ft.
Rock Pressure _____ lbs. _____ hrs.
Oil _____ bbls., 1st 24 hrs.
Fresh water _____ feet _____ feet
Salt water _____ feet _____ feet

Casing and Tubing	Used in Drilling	Left in Well	Packers
Size			Kind of Packer
16			
13			
10	<u>Pulled no record.</u>		Size of
8 1/4	<u>Pulled no record.</u>		
6 1/2		<u>2122</u>	Depth set
5 3/16		<u>2132.</u>	
3			Perf. top
2			Perf. bottom
Liners Used			Perf. top
			Perf. bottom

CASING CEMENTED _____ SIZE _____ No. Ft. _____ Date _____
COAL WAS ENCOUNTERED AT _____ FEET _____ INCHES
_____ FEET _____ INCHES _____ FEET _____ INCHES
_____ FEET _____ INCHES _____ FEET _____ INCHES

Formation	Color	Hard or Soft	Top	Bottom	Oil, Gas or Water	Depth Found	Remarks
Bluff Sand.			450	470.			
Pitts coal			835	842.			
B.D. Sand			1310	1390			
1st Salt Sand.			1510	1590			
2nd Salt Sand			1605	1710	<u>Water 1620.</u>		
Sand			1740	1900			
Maxon Sand			1980	2000			
Little Lime			2075	2080			
Pencil Cave			2080	2085			
Big Lime			2085	2170			
B.L. Sand			2170	2290			
Fifty Foot			2782	2828			
Thirty Foot			2862		<u>Gas 2869</u> <u>Oil 2870</u>		
Total Depth.			2880.				

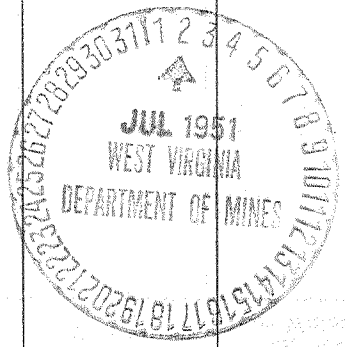

NOV 28 1951

