

New Location   
 Drill Deeper   
 Abandonment  9515 9514


MAP SHEET NO. 2221 TO 2226 P. 22

Company HOPE NATURAL GAS CO  
 Address CLARKSBURG WVA  
 Farm SARAH E MOORE

STATE OF WEST VIRGINIA  
 DEPARTMENT OF MINES  
 OIL AND GAS DIVISION  
 CHARLESTON

LATITUDE 39 37 30

LONGITUDE 80 01 30

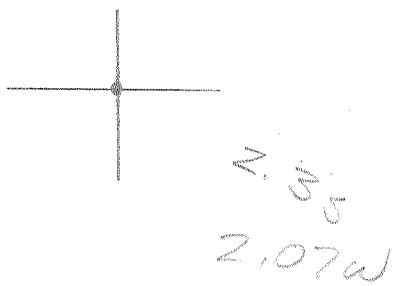

7'5 OGIS topo location

7.5' loc \_\_\_\_\_ 15' loc \_\_\_\_\_  
 (calc.) \_\_\_\_\_

Company 9515

Farm Sarah E Moore

Quad Grant Town

County Marion

District Mannington

WELL LOCATION MAP

File No. 30731

SARAH E. MOORE NO. 9515 WELL.

Peopler District, Marion County, W. Va.  
 By Hope Natural Gas Co., 445 W. Main St., Clarksburg, W. Va.  
 Abandoned under permit No. ....-11  
 On 166 acres.  
 Elevation, 1149' L.  
 Drilling commenced Oct. 25, 1917; completed Dec. 12, 1917.  
 Salt water at 1440'.  
 10" casing, 453'; 8", 1441'; 5", 1720'; 2" tubing, 1896'.  
 Casing not cemented.  
 Coal was encountered at 80-84 and 444-453'.  
 Gas well. Record to Dept. of Mines dated July 20, 1951.  
 Record to RPT from Mrs. Griffith Nov. 28, 1951. Old file No. 815.

	Top.	Bottom.
Coal	80	84
Pittsburgh Coal	444	453
Little Bankard Sand	856	866
Gas Sand	1035	1053
First Salt Sand	1185	1205
Second Salt Sand (water, 1440')	1360	1482
Maxton Sand	1575	1590
Little line	1665	1674
Pencil Cove	1674	1680
Big line	1680	1768
Big Injun Sand (gas, 1775, 1883')	1768	....
Total depth		1896



STATE OF WEST VIRGINIA  
DEPARTMENT OF MINES  
OIL AND GAS DIVISION

815

Permit No. MAR-731-A

WELL RECORD

Oil or Gas Well (KIND)


Company Hope Natural Gas Company.  
Address 445 West Main St. Clarksburg, W. Va.  
Farm Sarah E. Moore Acres 166  
Location (waters) \_\_\_\_\_  
Well No. 9515 Elev. 1149  
District Paw Paw County Marion  
The surface of tract is owned in fee by \_\_\_\_\_  
Address \_\_\_\_\_  
Mineral rights are owned by \_\_\_\_\_  
Address \_\_\_\_\_  
Drilling commenced Oct. 25, 1917  
Drilling completed Dec. 12, 1917  
Date Shot \_\_\_\_\_ From \_\_\_\_\_ To \_\_\_\_\_  
With \_\_\_\_\_  
Open Flow \_\_\_\_\_ /10ths Water in \_\_\_\_\_ Inch  
\_\_\_\_\_ /10ths Merc. in \_\_\_\_\_ Inch  
Volume \_\_\_\_\_ Cu. Ft.  
Rock Pressure \_\_\_\_\_ lbs. \_\_\_\_\_ hrs.  
Oil \_\_\_\_\_ bbls., 1st 24 hrs.  
Fresh water \_\_\_\_\_ feet \_\_\_\_\_ feet  
Salt water 1440 feet \_\_\_\_\_ feet

Casing and Tubing	Used in Drilling	Left in Well	Packers
Size			Kind of Packer
16			
13			
10	<u>453</u>	<u>453</u>	Size of
8 1/4	<u>1441</u>	<u>1441</u>	
6 5/8			Depth set
5 3/16	<u>1720</u>	<u>1720</u>	
3			Perf. top
2	<u>1896</u>	<u>1896</u>	Perf. bottom
Liners Used			Perf. top
			Perf. bottom

CASING CEMENTED NOT SIZE \_\_\_\_\_ No. Ft. \_\_\_\_\_ Date \_\_\_\_\_

COAL WAS ENCOUNTERED AT 80 FEET 48 INCHES  
444 FEET 108 INCHES FEET INCHES  
FEET INCHES FEET INCHES

Formation	Color	Hard or Soft	Top	Bottom	Oil, Gas or Water	Depth Found	Remarks
Coal			<u>80</u>	<u>84</u>			
Pittsburgh Coal			<u>444</u>	<u>453</u>			
Little Dunkard			<u>856</u>	<u>866</u>			
Gas sand			<u>1035</u>	<u>1053</u>			
First Salt			<u>1185</u>	<u>1205</u>			
Second Salt			<u>1360</u>	<u>1482</u>	water	<u>1440</u>	
Maxon			<u>1575</u>	<u>1590</u>			
Little Lime			<u>1665</u>	<u>1674</u>			
Pencil cave			<u>1674</u>	<u>1680</u>			
Big Lime			<u>1680</u>	<u>1768</u>			
Big Injun			<u>1768</u>		gas	<u>1775 1883</u>	
Total depth				<u>1896</u>			

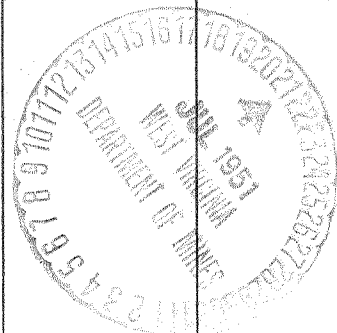

(Over)

NOV 20 1951

