

LATITUDE 39 2730

285
43W

LONGITUDE 80 15

7'5 OGIS topo location

7.5' loc _____

15' loc _____
(calc.) _____

Company _____

Farm W E SHAVER


Quad SHINNSTOWN

County MARION

District MINNINGTON

WELL LOCATION MAP

File No. 30748

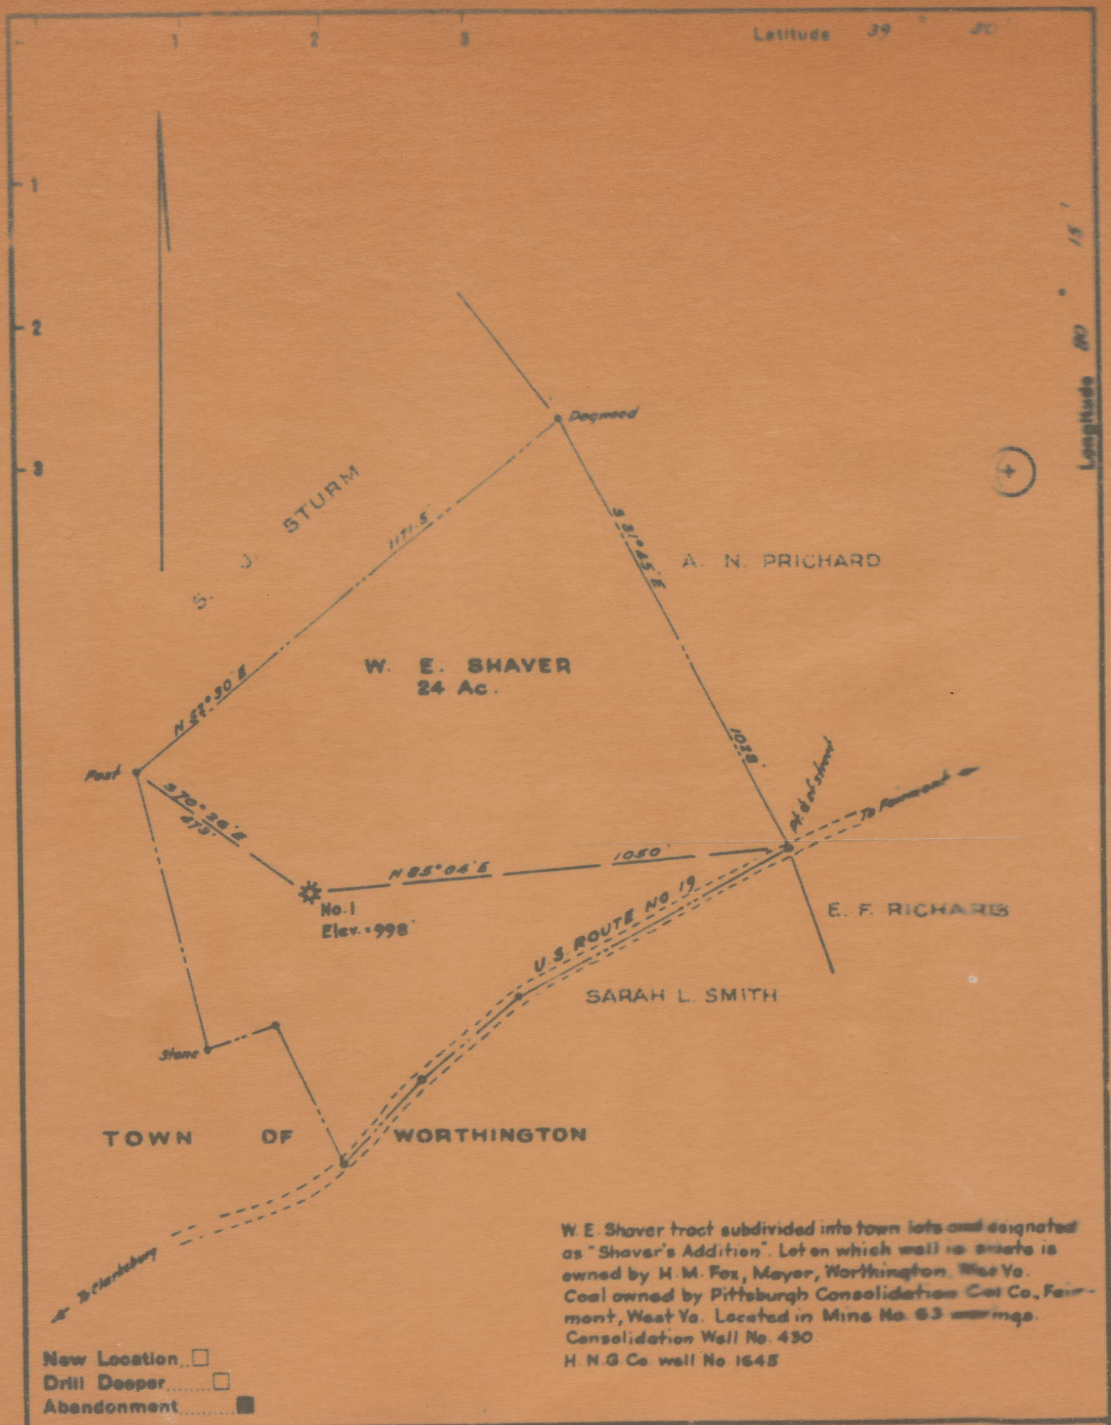

- New Location
- Drill Deeper
- Abandonment

W. E. Shaver tract subdivided into town lots and designated as "Shaver's Addition". Lots in which well is shown is owned by H. M. Fox, Mayer, Worthington, West Va. Coal owned by Pittsburgh Consolidation Coal Co., Fairmont, West Va. Located in Mine No. 63 workings. Consolidation Well No. 430. H. N. G. Co. well No. 1645

Company	VALLEY STEEL PRODUCTS CO.	
Address	St. Louis, Mo.	
Farm	W. E. Shaver	
Tract	Acres 24	Lease No.

STATE OF WEST VIRGINIA
DEPARTMENT OF MINES
OIL AND GAS DIVISION
CHARLESTON

Permit No. Ma-748 WELL RECORD

Oil or Gas Well _____
(KURE)

Company Valley Steel Products Company
Address St. Louis, Mo.
Farm W. E. Shaver Acres 24
Location (waters) Off Rt. 19 - Town of Worthington
Well No. 1 (Cons. #430) Elev. _____
District Lincoln County Marion
The surface of tract is owned in fee by H. M. Fox
Worthington Address W. Va.
Mineral rights are owned by _____
Address _____
Drilling commenced April 18, 1910
Drilling completed January 11, 1910
Date Shot _____ From _____ To _____
With _____

Casing and Tubing	Used in Drilling	Left in Well	Packers
16			Kind of Packer _____
18			Size of _____
10	174	174	Depth set _____
8 1/2	1520	1520	Perf. top _____
6 3/16	2344	2344	Perf. bottom _____
8			Perf. top _____
2			Perf. bottom _____
Liners Used _____			Perf. top _____
			Perf. bottom _____

Open Flow _____ /10ths Water in _____ Inch
_____ /10ths Merc. in _____ Inch
Volume _____ Cu. Ft.
Rock Pressure _____ lbs. _____ hrs.
Oil _____ bbls., 1st 24 hrs.
Fresh water _____ feet _____ feet
Salt water _____ feet _____ feet

CASING CEMENTED _____ SIZE _____ No. Ft. _____ Date _____
COAL WAS ENCOUNTERED AT _____ FEET _____ INCHES
_____ FEET _____ INCHES FEET _____ INCHES
_____ FEET _____ INCHES FEET _____ INCHES

Formation	Color	Hard or Soft	Top	Bottom	Oil, Gas or Water	Depth Found	Remarks
Pittsburgh Coal			138	147			
Dunkards			522	765			
Salt Sands			1068	1300			
Maxon			1390	1400			
Little Lime			1400	1430			
Big Lime			1440	1452			
Big Injun			1542	1642			
Fifty-foot Sand			2020	2140			
Shale							
Total Depth				2578			

1121571516