


LATITUDE 39 27 30

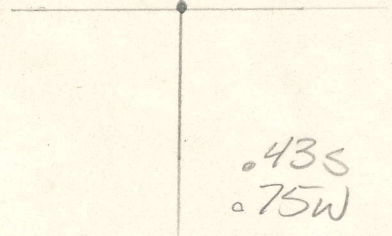

LONGITUDE 80 15

7'5 OGIS topo location

7.5' loc _____ 15' loc _____
 (calc.) _____

Company _____ 2230 _____

Farm CYRUS TETRICK


Quad SHINNISTON

County MARION

District LINCOLN

WELL LOCATION MAP

File No. 30751

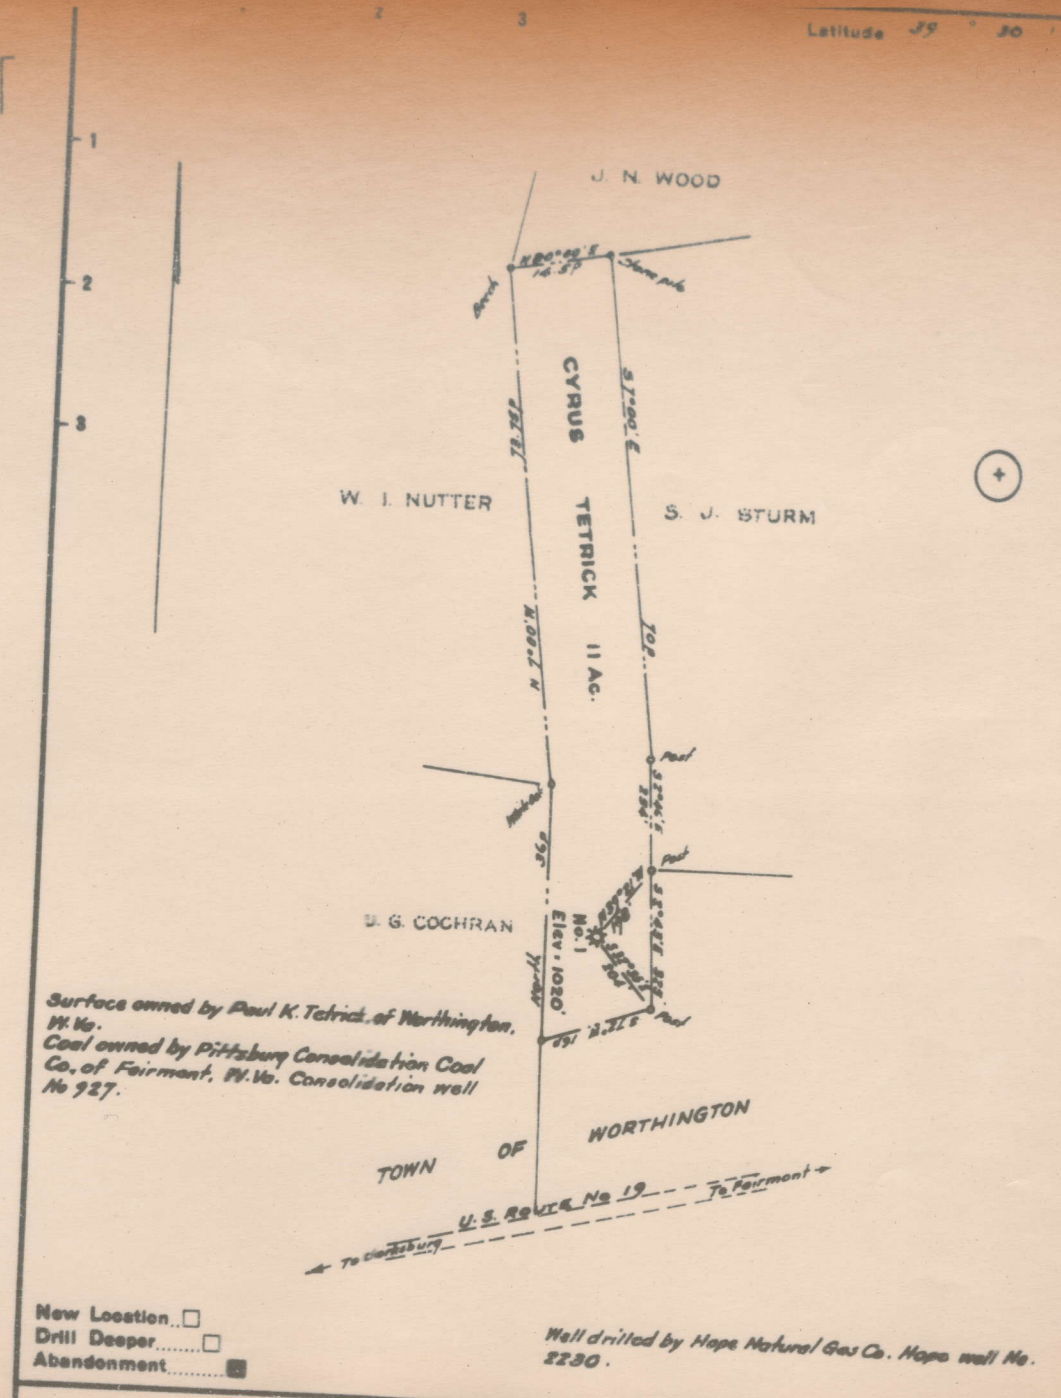

Surface owned by Paul K. Tetrick, of Worthington, W. Va.
 Coal owned by Pittsburg Consolidation Coal Co. of Fairmont, W. Va. Consolidation well No 927.

New Location
 Drill Deeper
 Abandonment

Well drilled by Hope Natural Gas Co. Hope well No. 2230.

Company VALLEY STEEL PRODUCTS CO.
 Address ST. LOUIS, MO.
 Farm Cyrus Tetrick
 Tract _____ Acres 11 Lease No. _____
 Well (Farm) No. 008 Series No. _____

STATE OF WEST VIRGINIA
 DEPARTMENT OF MINES
 OIL AND GAS DIVISION
 CHARLESTON
 WELL LOCATION

STATE OF WEST VIRGINIA
DEPARTMENT OF MINES
OIL AND GAS DIVISION

Permit No. 7744-751 WELL RECORD

Oil or Gas Well _____
(SINK)

Company Valley Steel Products Company
 Address St. Louis, Mo.
 Farm Cyrus Tietrick Area 11
 Location (waters) RFD #15 - Town of Worthington
 Well No. 1 (Hope #22230) Elev. 1020'
 District Lincoln County Marion
 The surface of tract is owned in fee by Paul K. Tietrick
Worthington Address W. Va.
 Mineral rights are owned by _____
 Address _____
 Drilling commenced May 27, 1910
 Drilling completed July 29, 1910
 Date Shot _____ From _____ To _____
 With _____
 Open Flow 1/16th Water in _____ Inch
1/16th Merc. in _____ Inch
 Volume _____ Cu. Ft.
 Rock Pressure _____ lbs. _____ hrs.
 Oil _____ bla., 1st 24 hrs.
 Fresh water _____ feet _____ feet
 Salt water _____ feet _____ feet

Casing and Tubing	Used in Drilling	Left in Well	Packers
Size			
16			Kind of Packer _____
18			
10	241'	241'	Size of _____
8 1/4	418'	418'	
6 3/4	1515'	1515'	Depth set _____
5 3/16	2397'	2397'	
3			Perf. top _____
2			Perf. bottom _____
Liners Used			Perf. top _____
			Perf. bottom _____

CASING CEMENTED SOME No. Ft. _____ Date _____

COAL WAS ENCOUNTERED AT FEET _____ INCHES _____
 FEET _____ INCHES _____ FEET _____ INCHES _____
 FEET _____ INCHES _____ FEET _____ INCHES _____

Formation	Collar	Hard or Set	Top	Bottom	Oil, Gas or Water	Depth Found	Remarks
Native Coal			55	60			
Pittsburgh	Coal		175	182			
Dunkard			675	715			
Salt Sand			1058	1208			
Little Lime			1447	1460			
Big Lime			1480	1570			
Big Injun			1570	1608			
Fifty-Foot Sand			2027	2067			
Thirty-Foot Sand			2077	2131			
Gordon			2373	2390			
Fourth Sand			2456	2481			
Fifth Sand			2532	2559			
Total Depth				2612'			