


LATITUDE 39 35

LONGITUDE 80 07 30

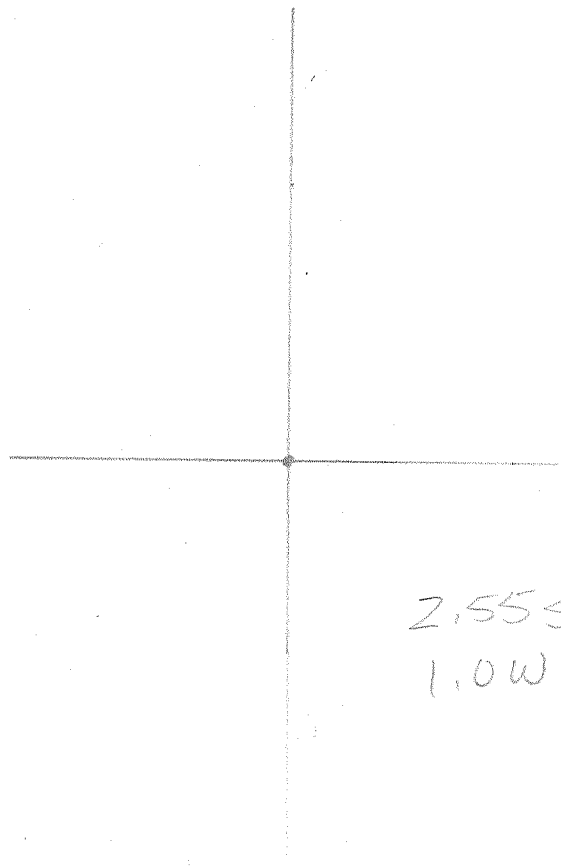

2.55S
1.0W

7'5 OGIS topo location

7.5' loc _____ 15' loc _____
 _____ (calc.) _____

Company _____ 99

Farm CHARLEY L. CLAYTON & al 2

Quad GRANT TOWN

County MARION

District PAW PAW

WELL LOCATION MAP

File No. 30762

Pawpaw District, Marion County, W. Va.
 By Wilhelm & Jackson, Hamlin, W. Va.
 Abandoned under permit Mar-.....-A?
 On 25 acres, on little Pawpaw Creek.
 Elevation, 1060' L.
 Drilling completed Nov. 6, 1926.
 Shot July 30, 1930, at 2252-2272', with 60 cts.
 16" casing, 16'; 10", 455'; 8", 1341'; 6", 1707'; 2" tubing, 2269';
 all left in.
 Hester anchor and wall packer, 6 5/8 x 16, Comb.
 Casing cemented, 10".
 Gas well. Record to Dept. of Mines stamped Jan. 24, 1952.
 Record to RCT from Mrs. Griffith May 21, 1952. O.F.No.832.

	Top.	Bottom.
Slate, sand, and lime	0	279
Mapletown (Sewickley) Coal	279	286
Slate, lime, and sand	286	398
Pittsburgh Coal (SLM)	398	404
(Coal cemented 50' above and 50' below with 35 sacks cement and 70 sacks of sand--Mr. Scott of the Consolidation Coal Co.)		
Slate, lime, and shells	404	800
Little Dunkard Sand	800	830
Slate and lime	830	940
Big Dunkard Sand	940	1015
Slate, sand, and lime	1015	1085
Gas Sand	1085	1140
Slate and lime	1140	1220
First Salt Sand	1220	1265
Coal (slate)	1265	1270
Slate	1270	1300
Second Salt Sand (water, 1325', 15 bailers per hour) (water, 1342', 15 bailers per hour)	1300	1362
Slate	1362	1367
Lime, red rock, and shells	1367	1657
Little Lime	1657	1675
Pencil Cave	1675	1680
Big Lime (SLM)	1680	1740
Big Injun Sand (break, red rock, (show gas, 1840-45', 1772-1775'))	1740	1865
Slate and shells (not tested))	1865	1930
Squaw Sand	1930	2005
Slate, shells, and lime	2005	2252
Gantz Sand (gas, 2254', 52 M.; gas, 2259', 203 M.; gas, 2264', 1,110 M. cu. ft.)	2252	2280
Total depth		2280
(Not through the Gantz Sand).		



832

STATE OF WEST VIRGINIA
DEPARTMENT OF MINES
OIL AND GAS DIVISION

WELL RECORD

Permit No. MAR-762-A

X Oil or Gas Well (KIND)

Company Wilhelm & Jackson
 Address Hamlin, West Virginia
 Farm Charley L. Clayton et al Acres 25
 Location (waters) Little Paw Paw Creek
 Well No. 2, Serial 99 Elev. 1060'
 District Paw Paw County Marion
 The surface of tract is owned in fee by _____
 Address _____
 Mineral rights are owned by _____
 Address _____
 Drilling commenced _____
 Drilling completed November 6, 1926
 Date Shot 7/30/1930 From 2252' To 2272'
 With 60 qts.
 Open Flow _____ /10ths Water in _____ Inch
 _____ /10ths Merc. in _____ Inch
 Volume _____ Cu. Ft.
 Rock Pressure _____ lbs. _____ hrs.
 Oil _____ bbls., 1st 24 hrs.
 Fresh water _____ feet _____ feet
 Salt water _____ feet _____ feet

Casing and Tubing	Used in Drilling	Left in Well	Packers
Size			
16		16'	Kind of Packer
13			Master Anchor
10	155'	155'	Size of <u>ball</u>
8 1/4	1341'	1341'	6-5/8" x 16"
6 5/8	1707'	1707'	Depth set <u>Comb</u>
5 3/16			
3			Perf. top
2	2269'	2269'	Perf. bottom
Liners Used			Perf. top
			Perf. bottom


CASING CEMENTED 10" SIZE No. Ft. _____ Date _____
 COAL WAS ENCOUNTERED AT _____ FEET _____ INCHES
 _____ FEET _____ INCHES FEET _____ INCHES
 _____ FEET _____ INCHES FEET _____ INCHES

Formation	Color	Hard or Soft	Top	Bottom	Oil, Gas or Water	Depth Found	Remarks
Slate, sand and lime			0	279			
Maplewood Coal			279	286			
Slate, lime and sand			286	398			
Pittsburgh Coal			398	404			
Slate, lime and shells			404	800			
Little Dunkard			800	830			
Slate and lime			830	940			
Big Dunkard			940	1015			
Slate, sand and lime			1015	1085			
Gas Sand			1085	1140			
Slate & lime			1140	1220			
First Salt Sand			1220	1265			
Coal (Slate)			1265	1270			
Slate			1270	1300			
Second Salt Sand			1300	1362			
Slate			1362	1367			
Lime, red rock and shells			1367	1657			
Little lime			1657	1675			
Pencil Cave			1675	1680			
Big lime			1680	1740			
Injun Sand			1740	1865			
break red rock			1772	1777			
Slate and shells			1865	1930			
Squaw Sand			1930	2005			
Slate, shells and lime			2005	2252			
Gantz Sand			2252	2280			
Total Depth drilled				2280			
Not through the Gantz Sand							

Steel Line Measurement
 Coal cemented 50' above and 50' below with 35 sacks cement and 70 sacks of sand - Mr. Scott of the Consolidation Coal Co.

Water 1325' - 15 bailers pr. hr.
 Water 1342' - 15 bl. per hr.

Steel Line Measurement
 show of gas 1840-1845-not tested
 Gas 2254' - 52 MCF
 Gas 2259' - 203 MCF
 Gas 2264 - 1,110 MCF

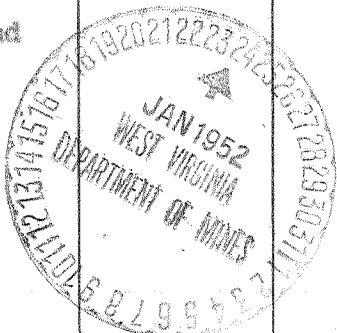

(Over) MAY 21 1952