


New Location
 Drill Deeper
 Abandonment

Company QUAKER STATE OIL CO.
 Address PARKERSBURG, W.VA.
 Farm MAHALA LOOMAN
 Tract _____ Acres 25 Lease No. _____
 Well (Farm) No. 1 Serial No. _____

STATE OF WEST VIRGINIA
 DEPARTMENT OF MINES
 OIL AND GAS DIVISION
 CHARLESTON
 WELL LOCATION MAP

LATITUDE 39 30

LONGITUDE 80 27 30

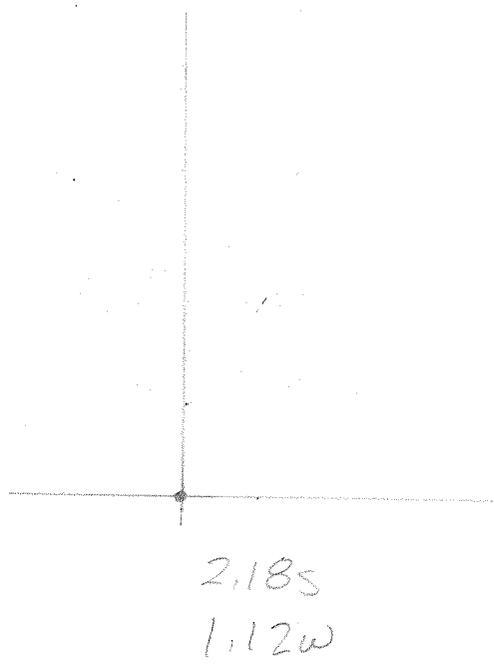

7'5 OGIS topo location

7.5' loc _____ 15' loc _____
 (calc.) _____

Company _____

Farm MAHARA LOOMAN 1

Quad WALLACE

County MARION

District MANNINGTON

WELL LOCATION MAP

File No. 30765

MAHIA LOOMAY NO.....WELL.

Wilmington District, Merion County, W. Va.
 By Cucker State Oil Refining Corp., Box 1709, Parkersburg, W. Va.
 Abandoned under permit No.-4?

On 25 acres, on Cucker Fork.

Elevation, 1442' L.

Minerals owned by W. Guy Tetrick, Clarksburg, W. Va.

Drilling commenced April 28, 1903; completed July 9, 1903.

10" casing, 174' (pulled); 8" ", 1735'; 6" ", 2670'; 2" tubing, 3373'.

Coal was encountered at 1250'.

Hole reduced at 3306'.

Oil well. Record to Dept. of Mines dated May 1, 1952.

Record to RCT from Mrs. Griffith Feb. 11, 1953. O.P.No. 864.

	Top.	Bottom.
Pittsburgh Coal	1250	-
Big Injun Sand	2540	- 2645
Gordon Stray Sand	3306	- 3320
Gordon Sand (oil and gas, 3352')	3342	- 3365
Total depth		3373



STATE OF WEST VIRGINIA
DEPARTMENT OF MINES
OIL AND GAS DIVISION

864

WELL RECORD

Permit No. MAR-765-A Oil or Gas Well OIL
(KIND)

Company QUAKER STATE OIL REFINING CORPORATION
Address Box 1789 Parkersburg, W. Va.
Farm Mahala Looman Acres 25
Location (waters) Quaker Fork
Well No. _____ Elev. 1,442'
District Mannington County Marion
The surface of tract is owned in fee by _____
Address _____
Mineral rights are owned by W. Guy Patrick
Address Clarksburg, W. Va.
Drilling commenced 4/28/53
Drilling completed 7/9/53
Date Shot _____ From _____ To _____
With _____
Open Flow _____ /10ths Water in _____ Inch
_____ /10ths Merc. in _____ Inch
Volume _____ Cu. Ft.
Rock Pressure _____ lbs. _____ hrs.
Oil _____ bbls., 1st 24 hrs.
Fresh water _____ feet _____ feet
Salt water _____ feet _____ feet

Casing and Tubing	Used in Drilling	Left in Well	Packers
Size			Kind of Packer
16			
13			
10	174		Size of
8 1/4	1735	1135	
6 5/8	2670	2670	Depth set
5 3/16			
3			Perf. top
2	3373	3373	Perf. bottom
Liners Used			Perf. top
			Perf. bottom

CASING CEMENTED _____ SIZE _____ No. Ft. _____ Date _____
COAL WAS ENCOUNTERED AT 1250 FEET _____ INCHES
_____ FEET _____ INCHES FEET _____ INCHES
_____ FEET _____ INCHES FEET _____ INCHES

Formation	Color	Hard or Soft	Top	Bottom	Oil, Gas or Water	Depth Found	Remarks
Pittsburgh Coal			1250				
Big Injun			2540	2645			
Gordon Stray			3306	3320			Hole reduced 3306
Gordon			3342	3365	OIL & Gas	3352	
Total Depth				3373			



