

- New Location
- Drill Deeper
- Abandonment


Coal - Mined out by Consolidation
 Coal Co. Baster Mine.
 Surface - Roland Wadsworth
 1203 Fleming Ave. Fairmont W. Va.

Company H. E. Walker
 Address 432N Bridge St Waynesburg Pa
 Farm Abbie Toothman
 Tract 1 Acres 2.74 Lease No. _____
 Well (Farm) No. 1 Serial No. _____

STATE OF WEST VIRGINIA
 DEPARTMENT OF MINES
 OIL AND GAS DIVISION
 CHARLESTON
 WELL LOCATION MAP

LATITUDE 39 35

LONGITUDE 80 07 30

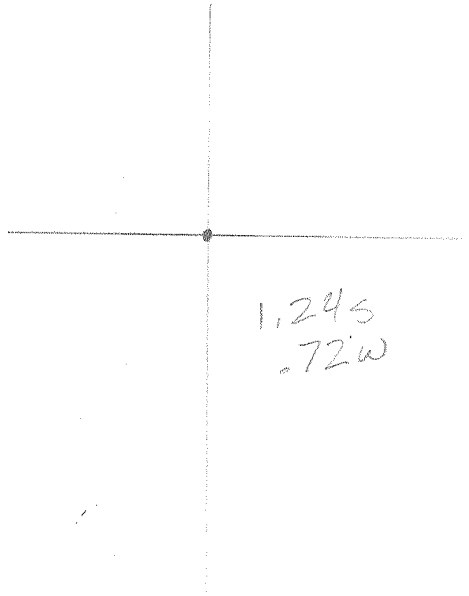

7'5 OGIS topo location

7.5' loc _____ 15' loc _____
 (calc.) _____

Company _____

Farm ABBIE TOOTHMAN 1

Quad GRANT TOWN

County MARION

District PAW PAW

WELL LOCATION MAP

File No. 30771

ABBIE TOTTENMAN NO. 1 WELL.

171A

Peopaw District, Marion County, W. Va.
 By E. A. Walker, 433 Bridge St., Wynchburg, Va.
 Abandoned under permit No.-87

On.....screen.

Elevation,' L.

Drilling completed July 26, 1926.

10" casing, 374'; 8", 1297'; 6", 1609'; 2" tubing, 1836'; all left in.

10" casing cemented, 50'.

Coal was encountered at 314-323'.

Oil well. Record to Sept. 27 pipe stamped July 14, 1952.

Record to 207 from Mrs. Griffith Dec. 2, 1952. C.P.No. 354.

	Top.	Bottom.
Pittsburgh Coal	314	- 323
Little Dunkard Sand	690	- 725
Big Dunkard Sand	800	- 935
Gas Sand	935	- 1070
1st Salt Sand	1140	- 1185
2nd Salt Sand	1235	- 1395
Big lime	1406	- 1576
Big Lujan Sand (oil, 1778-1786')	1576	- 1802
Square Sand	1890	- 1935
Shute Sand	2185	- 2325
70-Ft. Sand	2337	- 2352
Sand	2450	- 2748
Total depth		2825
Plugged back to		1846



STATE OF WEST VIRGINIA
DEPARTMENT OF MINES
OIL AND GAS DIVISION

8574

WELL RECORD

Permit No. MAR-771-A

Oil or Gas Well _____ (KIND)

Company H.E. Walker
Address 433 Bridge St. Waynesburg, Pa.
Farm Abbie Toothman Acres _____
Location (waters) _____
Well No. One Elev. _____
District Low Low County Marion
The surface of tract is owned in fee by _____
Address _____
Mineral rights are owned by _____
Address _____

Casing and Tubing	Used in Drilling	Left in Well	Packers
Size			Kind of Packer
16			
13			
10		374	Size of
8 1/4		1247	
6 5/8		1609	Depth set
5 3/16			
3			Perf. top
2		1836	Perf. bottom
Liners Used			Perf. top
			Perf. bottom

Drilling commenced _____
Drilling completed 7/26/1926
Date Shot _____ From _____ To _____
With _____
Open Flow _____ /10ths Water in _____ Inch
_____ /10ths Merc. in _____ Inch
Volume _____ Cu. Ft.
Rock Pressure _____ lbs. _____ hrs.
Oil _____ bbls., 1st 24 hrs.
Fresh water _____ feet _____ feet
Salt water _____ feet _____ feet

CASING CEMENTED 10" SIZE No. Ft. _____ Date _____
COAL WAS ENCOUNTERED AT 314 FEET 108 INCHES
FEET INCHES FEET INCHES
FEET INCHES FEET INCHES

Formation	Color	Hard or Soft	Top	Bottom	Oil, Gas or Water	Depth Found	Remarks
<u>pg. Coal</u>			<u>314</u>	<u>323</u>			
<u>Lt. Dunkard</u>			<u>690</u>	<u>725</u>			
<u>Big "</u>			<u>800</u>	<u>935</u>			
<u>Gas Sand.</u>			<u>935</u>	<u>1070</u>			
<u>1st. Salt.</u>			<u>1140</u>	<u>1185</u>			
<u>2nd Salt.</u>			<u>1215</u>	<u>1395</u>			
<u>Big Lime</u>			<u>1406</u>	<u>1576</u>			
<u>Injun.</u>			<u>1576</u>	<u>1802</u>	<u>Oil 1778-1786.</u>		
<u>Squaw Sand.</u>			<u>1890</u>	<u>1935</u>			
<u>Gantz Sand</u>			<u>2185</u>	<u>2325</u>			
<u>30 Ft.</u>			<u>2337</u>	<u>2352</u>			
<u>sand.</u>			<u>2450</u>	<u>2748</u>			
<u>Total Depth ..</u>				<u>2825.</u>			
<u>Plugged back to 1846. Total Depth now.</u>				<u>1846.</u>			

