

- New Locatin
- Drill Deep
- Abandonmet


Surface - Paul R McCoy
 RR.1 Rivesville W.Va
 Coal - Minadout - Consol Coal Co
 Baxter Mine

Company I. E. Walker
 Address 124 Bridge St. Waynesburg, Pa.
 Farm O. S. Jones
 Tract 1 Acres 13.1 Less to
 Well (Farm No. 1 Serial to

STATE OF WEST VIRGINIA
 DEPARTMENT OF MINES
 OIL AND GAS DIVISION
 CHARLESTON
 WELL LOCATION MAP

LATITUDE 39 35

LONGITUDE 80 07 30

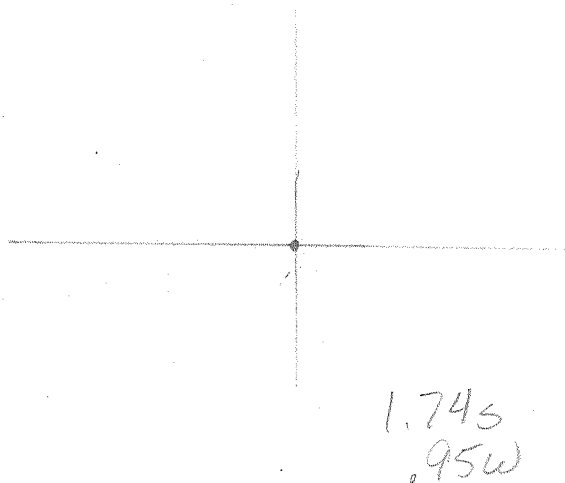

7'5 OGIS topo location

7.5' loc _____ 15' loc _____
 _____ (calc.) _____

Company _____

Farm O E JONES 1

Quad GRANT TOWN

County MARIETTA

District PAW PAW

WELL LOCATION MAP

File No. 30772

O. E. JONES NO. 1 WELL.

7228

Pawpaw District, Marion County, W. Va.
 By H. E. Walker, 437 Bridge St., Weyersburg, Pa.
 Abandoned under permit Mar-.....-47
 On.....acres.

Elevation,¹ L.

Drilling completed Feb. 20, 1926.

10" casing, 451'; 8", 1322'; 6", 1663'; 2" tubing, 1911'; all left in.

Coal was encountered at 389-397'.

Oil well. Record to Dept. of Mines stamped July 14, 1952.

Record to ROT from Mrs. Griffith Dec. 10, 1952. O.E.No.857.

	Top.	Bottom.
Pittsburgh Coal	389	- 397
Little Buckard Sand	770	- 800
Big Buckard Sand	960	- 1015
Gas Sand	1042	- 1148
1st Salt Sand	1215	- 1280
2nd Salt Sand	1315	- 1530
Big lime	1660	- 1730
Big Injun Sand (gas, 1754'; oil, 1848')	1730	- 1871
Total depth		1931



STATE OF WEST VIRGINIA
DEPARTMENT OF MINES
OIL AND GAS DIVISION

857

WELL RECORD

Permit No. MAN-772-A

Oil or Gas Well _____ (KIND)

Company H. B. Walker
Address 433 Bridge St., Raynoldsburg, Pa.
Farm C. E. Jones Acres _____
Location (waters) _____
Well No. One Elev. _____
District Four Ave County Marion
The surface of tract is owned in fee by _____
Address _____
Mineral rights are owned by _____
Address _____

Casing and Tubing Size	Used in Drilling	Left in Well	Packers
16			Kind of Packer
13			
10		471	Size of
8 1/4		1322	
6 5/8		1663	Depth set
5 3/16			
3			Perf. top
2		1911	Perf. bottom
Liners Used			Perf. top
			Perf. bottom

Drilling commenced _____
Drilling completed 2/20/1926
Date Shot _____ From _____ To _____
With _____
Open Flow _____ /10ths Water in _____ Inch
_____ /10ths Merc. in _____ Inch
Volume _____ Cu. Ft.
Rock Pressure _____ lbs. _____ hrs.
Oil _____ bbls., 1st 24 hrs.
Fresh water _____ feet _____ feet
Salt water _____ feet _____ feet

CASING CEMENTED	SIZE	No. Ft.	Date
COAL WAS ENCOUNTERED AT <u>389</u> FEET <u>96</u> INCHES			
	FEET	INCHES	FEET INCHES
	FEET	INCHES	FEET INCHES

Formation	Color	Hard or Soft	Top	Bottom	Oil, Gas or Water	Depth Found	Remarks
Pgh Coal			389	397			
Lt/Dunkard			770	800			
Big "			960	1015			
Gas Sand.			1042	1148			
1st Salt.			1215	1280			
2nd salt.			1315	1530			
Big Lime			1660	1730			
end/salt. Injun			1730	1871			
Total Depth.				1931	Gas 1754 Oil 1848.		

