


Longitude 80° 10'

1  
2  
3

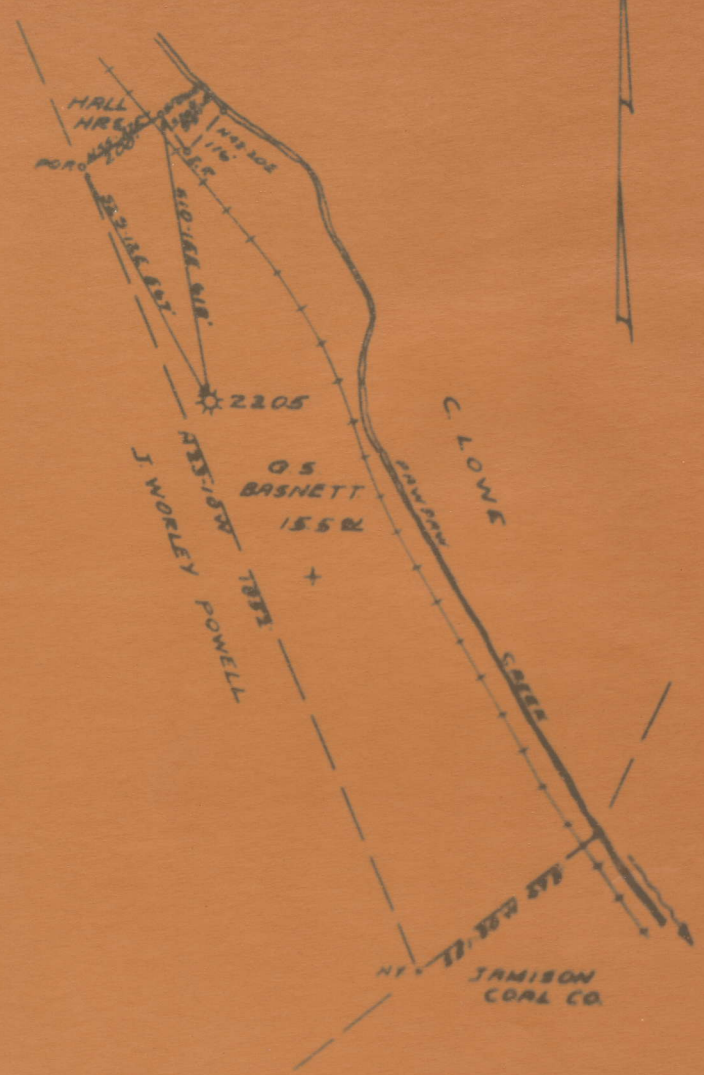

New Location   
 Drill Deeper   
 Abandonment

Company EQUITABLE GAS CO. WVA DIV  
 Address CLARKSBURG, WVA  
 Farm O. S. BASNETT  
 Tract \_\_\_\_\_ Acres 35 Lease No. 2609  
 Well (Farm) No. ONE Serial No. 2205  
 Elevation (Spirit Level) 1102 Y.A.

STATE OF WEST VIRGINIA  
 DEPARTMENT OF MINES  
 OIL AND GAS DIVISION  
 CHARLESTON

WELL LOCATION MAP  
 FILE NO. MAR-782A

LATITUDE 39 37 30

LONGITUDE 80 12 30

2.83 S  
1.5 W

7'5 OGIS topo location

7.5' loc \_\_\_\_\_ 15' loc \_\_\_\_\_  
(calc.) \_\_\_\_\_

Company \_\_\_\_\_ 2205

Farm GS BASNETT

Quad GRANT TOWN

County MARION

District Paw Paw

WELL LOCATION MAP

File No. 30792

Pawpaw District, Marion County, W. Va.  
 By Equitable Gas Co., W. Va. Div., Clarksburg, W. Va.  
 Abandoned under permit Mar-.....-A.

On 15 acres; Blacksville S/W 1-3.

Elevation, 1102' V. A.

Surface and minerals owned by Nancy Brock Powell, 230 Adams St.,  
 Fairmont, W. Va.

Drilling commenced Sept. 18, 1907; completed Nov. 28, 1907.

10" casing, 436' (pulled); 8", 1351'; 6", 1435'; 5", 1913'.

Coal was encountered at 310-315 and 395-400'.

Gas well. Record to Dept. of Mines dated April 7, 1944; stamped  
 Sept. 2, 1952.

Record to RGT from Mrs. Griffith Feb. 11, 1953. O.F.No. 861.

|                                   | Top. | Bottom. |
|-----------------------------------|------|---------|
| Bluff Sand, white, hard           | 0    | 60      |
| Slate, black, soft                | 60   | 80      |
| Lime, white, hard                 | 80   | 160     |
| Sand, white, hard                 | 160  | 180     |
| Slate, white, soft                | 180  | 195     |
| Lime, white, hard                 | 195  | 270     |
| Sand, white, hard                 | 270  | 310     |
| Mapletown (Sewickley) coal        | 310  | 315     |
| Lime, white, hard                 | 315  | 395     |
| Pittsburgh Coal                   | 395  | 400     |
| Slate, white, soft                | 400  | 535     |
| Red rock, soft                    | 535  | 575     |
| Lime, white, hard                 | 575  | 590     |
| Red rock, soft                    | 590  | 615     |
| Lime, white, soft                 | 615  | 630     |
| Red rock, soft                    | 630  | 660     |
| Slate, black, soft                | 660  | 720     |
| Lime, white, hard                 | 720  | 770     |
| Red rock, soft                    | 770  | 830     |
| Lime, white, hard                 | 830  | 855     |
| Slate, black, soft                | 855  | 915     |
| Little Dunkard Sand, hard         | 915  | 960     |
| Lime, white, hard                 | 960  | 1000    |
| Slate, black, soft                | 1000 | 1020    |
| Big Dunkard, hard                 | 1020 | 1045    |
| Slate, white, soft                | 1045 | 1085    |
| Lime, white, hard                 | 1085 | 1115    |
| Red rock, soft                    | 1115 | 1140    |
| Slate, black, soft                | 1140 | 1156    |
| Gas Sand, hard                    | 1156 | 1221    |
| Slate, black, soft                | 1221 | 1251    |
| Lime, white, hard                 | 1251 | 1311    |
| Red rock, soft                    | 1311 | 1327    |
| Salt Sand, hard                   | 1327 | 1421    |
| Sand, black                       | 1421 | 1451    |
| Red rock, soft                    | 1451 | 1551    |
| Lime, white, hard                 | 1551 | 1571    |
| Slate, black, soft                | 1571 | 1617    |
| Little Lime, hard                 | 1617 | 1627    |
| Pencil Cave, soft                 | 1627 | 1635    |
| Big Lime, hard                    | 1635 | 1705    |
| Big Injun Sand, hard (gas, 1800') | 1705 | 1880    |

(OVER)

C. B. BASNETT NO. 2205 WELL (Continued).

|                         | Top. | Bottom. |
|-------------------------|------|---------|
| Slate, black, soft      | 1880 | - 1890  |
| Lime, white, hard       | 1890 | - 1910  |
| Sandy Sand, hard        | 1910 | - 1990  |
| Lime, white, hard       | 1990 | - 2252  |
| Gault Sand, white, hard | 2252 | - 2282  |
| Fifty-foot Sand, hard   | 2282 | - 2290  |
| Fifty-foot Sand         | 2290 | - 2455  |
| Lime, hard              | 2455 | - 2480  |
| Slate and shells        | 2480 | - 2555  |
| Gordon Stray Sand, hard | 2555 | - 2595  |
| Slate, soft             | 2595 | - 2600  |
| Gordon Sand, hard       | 2600 | - 2630  |
| Slate, soft             | 2630 | - 2660  |
| 4th Sand, hard          | 2660 | - 2690  |
| Slate and shell         | 2690 | - 2785  |
| 5th Sand (gas, 2787')   | 2785 | - 2805  |
| Slate                   | 2805 | - 2825  |
| Total depth             |      | 2825    |



861

STATE OF WEST VIRGINIA  
DEPARTMENT OF MINES  
OIL AND GAS DIVISION

WELL RECORD

Permit No. MAR-782-A  
BOUYASIE GAS COMPANY- WEST VA DIV.

Oil or Gas Well "GAS"  
(KIND)


Company Pittsburgh & West Va Gas Company  
Address Clarksburg, West Va.,  
Farm G. S. Bassett Acres 15  
Location (waters) Blks. S/W. 1/3  
Well No. 2205 Elev. 1102' VA  
District Paw Paw County Marion  
The surface of tract is owned in fee by Nancy Brock Powell  
230 Adams Street Falmont, W. Va.  
Address  
Mineral rights are owned by Nancy Brock Powell  
230 Adams Street Falmont, W. Va.  
Address  
Drilling commenced September 18, 1907  
Drilling completed November 28, 1907  
Date Shot From To  
With

| Casing and Tubing | Used in Drilling | Left in Well | Packers        |
|-------------------|------------------|--------------|----------------|
| Size              |                  |              |                |
| 16                |                  |              | Kind of Packer |
| 18                |                  |              |                |
| 10                | 436'             | None         | Size of        |
| 8 1/4             | 1351'            | 1351'        |                |
| 6 3/8             | 1435'            | 1435'        | Depth set      |
| 5 3/16            | 1913'            | 1913'        |                |
| 3                 |                  |              | Perf. top      |
| 2                 |                  |              | Perf. bottom   |
| Liners Used       |                  |              | Perf. top      |
|                   |                  |              | Perf. bottom   |

Open Flow /10ths Water in \_\_\_\_\_ Inch  
/10ths Merc. in \_\_\_\_\_ Inch  
Volume \_\_\_\_\_ Cu. Ft.  
Rock Pressure \_\_\_\_\_ lbs. \_\_\_\_\_ hrs.  
Oil \_\_\_\_\_ bbls., 1st 24 hrs.  
Fresh water \_\_\_\_\_ feet \_\_\_\_\_ feet  
Salt water \_\_\_\_\_ feet \_\_\_\_\_ feet

CASING CEMENTED \_\_\_\_\_ SIZE \_\_\_\_\_ No. Ft. \_\_\_\_\_ Date \_\_\_\_\_  
COAL WAS ENCOUNTERED AT 310 FEET 60 INCHES  
395 FEET 60 INCHES FEET INCHES  
FEET INCHES FEET INCHES

| Formation       | Color | Hard or Soft | Top  | Bottom | Oil, Gas or Water | Depth Found | Remarks |
|-----------------|-------|--------------|------|--------|-------------------|-------------|---------|
| Bluff Sand      | White | Hard         | 0    | 60     |                   |             |         |
| Slate           | Black | Soft         | 60   | 80     |                   |             |         |
| Lime            | White | Hard         | 80   | 160    |                   |             |         |
| Sand            | "     | "            | 160  | 180    |                   |             |         |
| Slate           | "     | Soft         | 180  | 195    |                   |             |         |
| Lime            | "     | Hard         | 195  | 270    |                   |             |         |
| Sand            | "     | "            | 270  | 310    |                   |             |         |
| Maple Town Coal |       |              | 310  | 315    |                   |             |         |
| Lime            | White | Hard         | 315  | 395    |                   |             |         |
| Pgh. Coal       |       |              | 395  | 400    |                   |             |         |
| Slate           | White | Soft         | 400  | 535    |                   |             |         |
| Red Rock        | Red   | Soft         | 535  | 575    |                   |             |         |
| Lime            | White | Hard         | 575  | 590    |                   |             |         |
| Red Rock        | Red   | Soft         | 590  | 615    |                   |             |         |
| Lime            | White | "            | 615  | 630    |                   |             |         |
| Red Rock        | Red   | "            | 630  | 660    |                   |             |         |
| Slate           | Black | "            | 660  | 720    |                   |             |         |
| Lime            | White | Hard         | 720  | 770    |                   |             |         |
| Red Rock        | Red   | Soft         | 770  | 830    |                   |             |         |
| Lime            | White | Hard         | 830  | 855    |                   |             |         |
| Slate           | Black | Soft         | 855  | 915    |                   |             |         |
| Dunkard         |       | Hard         | 915  | 960    |                   |             |         |
| Lime            | White | "            | 960  | 1000   |                   |             |         |
| Slate           | Black | Soft         | 1000 | 1020   |                   |             |         |
| Dunkard         |       | Hard         | 1020 | 1045   |                   |             |         |
| Slate           | White | Soft         | 1045 | 1085   |                   |             |         |
| Lime            | "     | Hard         | 1085 | 1115   |                   |             |         |
| Red Rock        | Red   | Soft         | 1115 | 1140   |                   |             |         |
| Slate           | Black | "            | 1140 | 1156   |                   |             |         |
| Gas Sand        |       | Hard         | 1156 | 1221   |                   |             |         |
| Slate           | Black | Soft         | 1221 | 1251   |                   |             |         |
| Lime            | White | Hard         | 1251 | 1311   |                   |             |         |
| Red Rock        | Red   | Soft         | 1311 | 1327   |                   |             |         |
| Salt Sand       |       | Hard         | 1327 | 1421   |                   |             |         |
| Sand            | Black | "            | 1421 | 1451   |                   |             |         |
| Red Rock        | Red   | Soft         | 1451 | 1551   |                   |             |         |
| Lime            | White | Hard         | 1551 | 1571   |                   |             |         |
| Slate           | Black | Soft         | 1571 | 1617   |                   |             |         |
| Little Lime     |       | Hard         | 1617 | 1627   |                   |             |         |

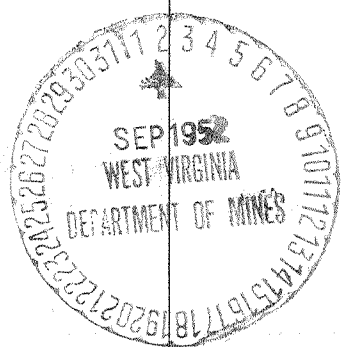

| Formation       | Color | Hard or Soft | Top  | Bottom | Oil, Gas or Water | Depth Found | Remarks |
|-----------------|-------|--------------|------|--------|-------------------|-------------|---------|
| Pencil Cave     |       | Soft         | 1627 | 1635   |                   |             |         |
| Big Line        |       | Hard         | 1635 | 1705   |                   |             |         |
| Big Injun       |       | "            | 1705 | 1880   |                   |             |         |
| Slate           | Black | Soft         | 1880 | 1890   | Gas               | 1800'       |         |
| Lime            | White | Hard         | 1890 | 1910   |                   |             |         |
| Squaw Sand      |       | "            | 1910 | 1990   |                   |             |         |
| Lime            | White | "            | 1990 | 2252   |                   |             |         |
| Gants Sand      | "     | "            | 2252 | 2282   |                   |             |         |
| Fifty Foot Sand | "     | "            | 2282 | 2290   |                   |             |         |
| "               | "     | "            | 2290 | 2455   |                   |             |         |
| Lime            |       | Hard         | 2455 | 2480   |                   |             |         |
| Slate&Shells    |       | "            | 2480 | 2555   |                   |             |         |
| Gordon Stray    |       | Hard         | 2555 | 2595   |                   |             |         |
| Slate           |       | Soft         | 2595 | 2600   |                   |             |         |
| Gordon Sand     |       | Hard         | 2600 | 2630   |                   |             |         |
| Slate           |       | Soft         | 2630 | 2660   |                   |             |         |
| 4th. Sand       |       | Hard         | 2660 | 2690   |                   |             |         |
| Slate&Shell     |       | "            | 2690 | 2785   |                   |             |         |
| 5th. Sand       |       | "            | 2785 | 2805   | Gas               | 2787'       |         |
| Slate           |       | "            | 2805 | 2825   |                   |             |         |
| Total Depth     |       |              |      | 2825   |                   |             |         |

April 7, 1944

Date EQUITABLE GAS COMPANY - WEST VA. DIV. 194  
 PETROLEUM & GASES COMPANY, INC.

APPROVED

By W. E. Masten Owner  
 (Title)

Record of Well No. 2205 Located on G. S. Basnett Farm July 13 1907  
Paw Paw District Marion County W. Va. State  
 Division A District No. 11 Drilled under well Order  
 Rig built by Jno. Craig Began 19 Completed Sept. 16 1907  
 Well drilled by W. J. Chesney Began Sept. 19 1907 Completed Nov. 28 1907  
 Depth of Well 2825 feet Size of Hole 5 3/16 Producing Gas.  
 Elev: 1102.6

| CASED WITH |        |      | REMARKS                |
|------------|--------|------|------------------------|
| AMOUNT     | SIZE   | KIND |                        |
| 16'        | 1 3/2" | Wood |                        |
| 1436       | 10"    | Old  |                        |
| 1351       | 8 1/4" | "    |                        |
| 1435       | 6 9/8" | "    |                        |
| 1913       | 5 3/16 | New  | 1-5 3/16 B. H. Packer. |
| 2825       | 2"     |      | Reclaimed.             |

COAL VEINS Mapletown 310-315 Pg. 395-401

| FORMATIONS          |       |                               |      |        |  |
|---------------------|-------|-------------------------------|------|--------|--|
| FORMATION           | COLOR | OPEN OR CLOSE<br>HARD OR SOFT | TOP  | BOTTOM | REMARKS<br>GAS-OIL-WATER<br>(THICKNESS OF PAY) |
| <u>Big Run sand</u> |       |                               | 910  | 970    |  |
| <u>Gas sand</u>     |       |                               | 1100 | 1165   |  |
| <u>salt "</u>       |       |                               | 1327 | 1413   |  |
| <u>Big Lime</u>     |       |                               | 1635 |        |  |
| <u>Big Run sand</u> |       |                               | 1705 | 1880   | Gas at 1800                                    |
| <u>Bunker</u>       |       |                               | 1891 | 1910   | " " 2787                                       |
| <u>South sand</u>   |       |                               | 2252 | 2282   |  |
| <u>Fifth sand</u>   |       |                               | 2290 | 2405   |  |
| <u>Wood sand</u>    |       |                               | 2600 | 2680   |  |
| <u>Gas sand</u>     |       |                               | 2555 | 2565   | Drillers record.                               |
| <u>South sand</u>   |       |                               | 2690 | 2720   | Fourth sand 2660 to 2690.                      |
| <u>Fifth sand</u>   |       |                               | 2785 | 2805   |  |

FIRST PRESSURE TEST IN 6 3/16" CASING

REMARKS

|               |                         |                     |  |
|---------------|-------------------------|---------------------|--|
| 30 Sec.       | <u>3</u>                | lbs.                | Shot with 40 gals. 1-26-17<br>Bottom shell 2801'<br>1.7 W2" after. -5 W1" before |
| 1 Min.        | <u>5</u>                | "                   |  |
| 2 "           | <u>8</u>                | "                   |  |
| 5 "           | <u>15</u>               | "                   |  |
| 10 "          | <u>29</u>               | "                   |  |
| 20 "          | <u>57</u>               | "                   |  |
| 30 "          |                         | "                   | May 1916. 4 W1" 23,640 <sup>290-48 hrs.</sup>                                    |
| Rock Pressure | <u>298</u>              | " in <u>12</u> fms. | June 1917. 4 W2" 94,560 <sup>261-48 hrs.</sup>                                   |
| Taken         | <u>Jan. 26 1917</u>     | 19                  | June 1918. 2 W2" 67,392 <sup>236-48 hrs.</sup>                                   |
| By            | <u>J. F. Ashenburt.</u> |                     |  |

WELL TUBED AND PACKED Feb. 1st 1917

VIZ:- 140 gals. 2852 of 2"  
1- 5 3/16 X 3" Larkin Anchor  
9 gals 113' of anchor.  
1- 2" B+L.

FIRST PRESSURE TEST IN \_\_\_\_\_ TUBING

REMARKS

|               |                         |      |  |
|---------------|-------------------------|------|--|
| 30 Sec.       | <u>14</u>               | lbs. |  |
| 1 Min.        | <u>20</u>               | "    |  |
| 2 "           | <u>30</u>               | "    |  |
| 5 "           | <u>58</u>               | "    |  |
| 10 "          | <u>92</u>               | "    |  |
| 20 "          | <u>134</u>              | "    |  |
| 30 "          |                         | "    |  |
| Rock Pressure |                         | " in |  |
| Taken         | <u>Feb 1st 1917</u>     | 19   |  |
| By            | <u>J. F. Ashenburt.</u> |      |  |

MATERIAL FOR THIS WELL RECEIVED FROM FOLLOWING SOURCES:

1 Old rig complete from J. A. Lamb #400 00  
2837 of 2"