

New Location...
 Drill Deeper.....
 Abandonment.....

Company CARNEGIE NATURAL GAS
 Address PITTSBURGH PA.
 Farm N.D. LINGER
 Tract _____ Acres 54 Lease No. E6451-42
 Well (Farm) No. 1 Serial No. E 647
 Elevation (Spirit Level) 1129'
 Quadrangle BLACKVILLE S.W.
 County MARION District PAW PAW
 Engineer John O. Theobald
 Engineer's Registration No. 1850
 File No. _____ Drawing No. _____
 Date 10-22-53 Scale 1" = 40 POLES

STATE OF WEST VIRGINIA
 DEPARTMENT OF MINES
 OIL AND GAS DIVISION
 CHARLESTON

WELL LOCATION MAP
 FILE NO. MAR-797-A

+ Denotes location of well on United States Topographic Maps, scale 1 to 62,500, latitude and longitude lines being represented by border lines as shown.

- Denotes one inch spaces on border line of original tracing.

N.D. LINGER 10.1 (E-647) - CARNEGIE N, G, Co. - MAR-797A



STATE OF WEST VIRGINIA
DEPARTMENT OF MINES
OIL AND GAS DIVISION

884

Blacksville

WELL RECORD
WELL TO BE ABANDONED

Oil or Gas Well **GAS**
(KIND)

Permit No. 797A

Company Carnegie Natural Gas Company,
Address 1015 Frick Building, Pittsburgh 19, Pa.
Farm N. D. Linger Acres 5 1/2
Location (waters) Ministers Run
Well No. 647 Elev. 1129
District Paw Paw County Marion
The surface of tract is owned in fee by Elmer Crone,
Rt. #1, Rivesville Address West Virginia
Mineral rights are owned by See Below

Casing and Tubing	Used in Drilling	Left in Well	Packers
Size			Kind of Packer
16			
13			
10	480	480	Size of
8 1/2	1450	1450	
6 5/8	1724	1724	Depth set
5 3/16			
3			Perf. top
2	2330	2330	Perf. bottom
Liners Used			Perf. top
			Perf. bottom

Drilling commenced 9-15-16
Drilling completed 4-1-17
Date Shot _____ From _____ To _____
With _____
Open Flow _____ /10ths Water in _____ Inch
_____ /10ths Merc. in _____ Inch
Volume 554,000 Cu. Ft.
Rock Pressure _____ lbs. _____ hrs.
Oil _____ bbls., 1st 24 hrs.
Fresh water _____ feet _____ feet
Salt water _____ feet _____ feet


CASING CEMENTED _____ SIZE _____ No. Ft. _____ Date _____

COAL WAS ENCOUNTERED AT 332 FEET _____ INCHES
422 FEET _____ INCHES FEET _____ INCHES
_____ FEET _____ INCHES FEET _____ INCHES

Formation	Color	Hard or Soft	Top	Bottom	Oil, Gas or Water	Depth Found	Remarks
Mapleton Coal			332	340			
Pittsburgh Coal			422	430			
Gas Sand			1095	1170			
1st Salt Sand			1245	1270			
2nd Salt Sand			1275	1460			
Little Lime			1655	1685			
Pencil Cave			1685	1700			
Big Lime			1700	1767			
Big Injun			1767	1914	Gas	1773-1778	
					Gas	1875-1880	
Gantz Sand			2293	2330	Gas	2297	
			TOTAL DEPTH	2330			

MINERAL RIGHTS ARE OWNED BY:

- Delia M. Hess, Attorney-in-fact,
21-11th St., 3rd Floor,
Wheeling, W. Va.
- Lucretia M. Eddy,
R.F.D. #3, Fairview, W. Va.
- Marjorie Matarazzo,
P. O. Box #12, Dobbs Ferry, N. Y.
- Angelika Morris,
409 Virginia Avenue,
Fairmont, W. Va.
- Goldie May Ammons, Attorney-in-fact for Heirs of Wilbert W. Ammons,
Route #1, Rivesville, W. Va.
- Mary T. Edwards,
P. O. Box #477,
Safety Harbor, Florida.

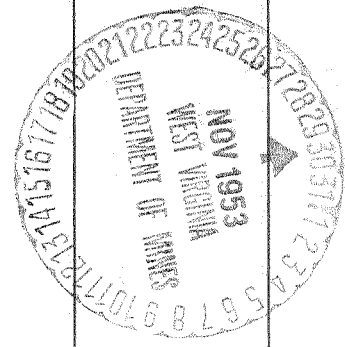

(Over)

MAY 10 1954

Formation	Color	Hard or Soft	Top	Bottom	Oil, Gas or Water	Depth Found	Remarks
						1400 gal - 8 hrs 97' dep. 80' feet	

Date November 25, 19 53

APPROVED CARNEGIE NATURAL GAS COMPANY, Owner

By B. N. Tucker (Title) Land Agent