

Surface owned by Lloyd Glover.  
 Address: Mr. Lloyd Glover, Metz, W. Va.  
 Coal owned by The Charleston National Bank, Trustee.  
 Address: Bernard G. Sampson, Engr. P.O. Box 368, Fairmont, W. Va.

New Location...   
 Drill Deeper...   
 Abandonment...

FEB. 6 1956

On 800' Map N 60 E. Sqs. N 9 E 14.

Company William Moses  
 Address Salem, W. Va.  
 Farm Martha Rowand  
 Tract \_\_\_\_\_ Acres 97 1/4 Lease No. \_\_\_\_\_  
 Well (Farm) No. 3 Serial No. 5349  
 Elevation (Spirit Level) Floor - 1162.42  
Ground - 1160.82  
 Quadrangle Mannington  
 County Marion District Mannington  
 Engineer Elworth Stainer  
 Engineer's Registration No. 2221  
 File No. \_\_\_\_\_ Drawing No. \_\_\_\_\_  
 Date Jan. 2nd, 1956 Scale 1" = 500 Feet

STATE OF WEST VIRGINIA  
 DEPARTMENT OF MINES  
 OIL AND GAS DIVISION  
 CHARLESTON

WELL LOCATION MAP  
 FILE NO. MAR-826-A

+ Denotes location of well on United States Topographic Maps, scale 1 to 62,500, latitude and longitude lines being represented by border lines as shown.  
 - Denotes one inch spaces on border line of original tracing.

MARTHA ROWAND No. 3 (5349) WILLIAM MOSES - MAR-826-A



STATE OF WEST VIRGINIA  
DEPARTMENT OF MINES  
OIL AND GAS DIVISION

WELL RECORD

Oil or Gas Well (KIND)

Permit No. 8-16-A


Company William Moses  
Address Salem, W. Va.  
Farm Martha Rowand Acres 97 1/2  
Location (waters) \_\_\_\_\_  
Well No. Three (5249) Elev. 1160.82  
District Mannington County Marion  
The surface of tract is owned in fee by Lloyd Glover  
Address Metz, W. Va.  
Mineral rights are owned by Charleston Nat'l Bank  
B. G. Sampson Box 368 Address Fairmont, W. Va.  
Drilling commenced Jan 30, 1924  
Drilling completed April 6th, 1924  
Date Shot \_\_\_\_\_ From \_\_\_\_\_ To \_\_\_\_\_  
With \_\_\_\_\_

Casing and Tubing	Used in Drilling	Left in Well	Packers
Size			Kind of Packer
16			
18			
10		267	Size of
8 1/4		1370	
6 5/8		2221	Depth set
5 3/16			
3			Perf. top
2			Perf. bottom
Liners Used			Perf. top
			Perf. bottom

Open Flow \_\_\_\_\_ /10ths Water in \_\_\_\_\_ Inch  
\_\_\_\_\_ /10ths Merc. in \_\_\_\_\_ Inch  
Volume \_\_\_\_\_ Cu. Ft.  
Rock Pressure \_\_\_\_\_ lbs. \_\_\_\_\_ hrs.  
Oil \_\_\_\_\_ bbls., 1st 24 hrs.  
Fresh water \_\_\_\_\_ feet \_\_\_\_\_ feet  
Salt water \_\_\_\_\_ feet \_\_\_\_\_ feet

CASING CEMENTED \_\_\_\_\_ SIZE \_\_\_\_\_ No. Ft. \_\_\_\_\_ Date \_\_\_\_\_  
COAL WAS ENCOUNTERED AT 882 FEET 96 INCHES  
\_\_\_\_\_ FEET \_\_\_\_\_ INCHES \_\_\_\_\_ FEET \_\_\_\_\_ INCHES  
\_\_\_\_\_ FEET \_\_\_\_\_ INCHES \_\_\_\_\_ FEET \_\_\_\_\_ INCHES

Formation	Color	Hard or Soft	Top	Bottom	Oil, Gas or Water	Depth Found	Remarks
Pitts Coal			882	890			
Big Dunkard			1355	1392			
salt Sand			1691	1938			
Big Lime			2125	2185			
Big Injun			2185	2365			
50 foot			2850	2900			
30 Foot			2922	2946			
Total Depth			2947				

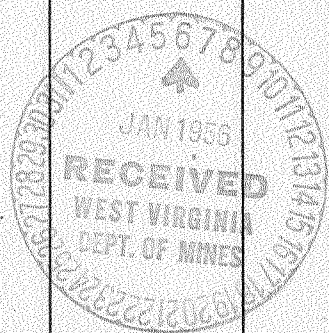

JUNE 21 1956