


LATITUDE 39 35

LONGITUDE 80 25

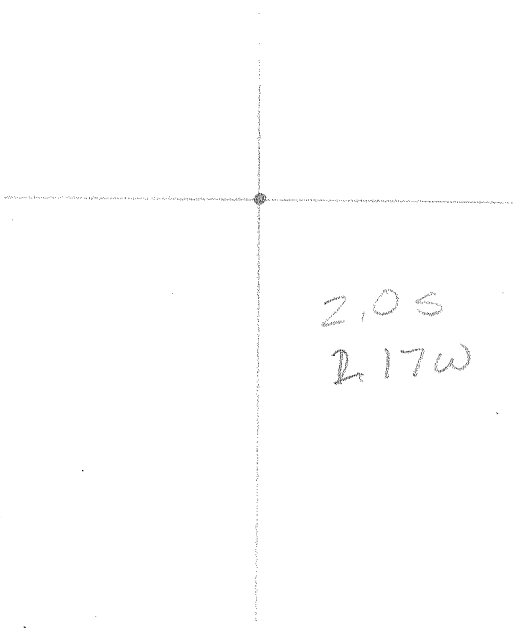

7'5 OGIS topo location

7.5' loc _____ 15' loc _____
 (calc.) _____

Company _____

Farm ES EVANS I

Quad GLOVER GAP

County MARION

District MANNINGTON

WELL LOCATION MAP

File No. 30848

