

New Location
 Drill Deeper
 Abandonment

NOV 26 1961

4116
 5.25 5.29

MAP SHEET 27, N-10E-21; F.B. 1244, P. 3 & 4

Company	HOPE NATURAL GAS CO.
Address	CLARKSBURG, W.VA.
Farm	JOS. L. TENNANT
Tract	Acres 0.75 Lease No. 5052
Well (Farm) No.	Serial No. 740
Elevation (Spirit Level)	1072'
Quadrangle	BLACKSVILLE W.C.
County	MARION District PAW PAW
Engineer	Jackson M. Jarvis.
Engineer's Registration No.	2397
File No.	Drawing No.
Date	10/31/61 Scale 1" = 50'

STATE OF WEST VIRGINIA
 DEPARTMENT OF MINES
 OIL AND GAS DIVISION
 CHARLESTON

WELL LOCATION MAP
 FILE NO. MAR-907-A

+ Denotes location of well on United States Topographic Maps, scale 1 to latitude and longitude lines being represented by border lines as shown.

- Denotes one inch spaces on border line of original tracing.



943

STATE OF WEST VIRGINIA
DEPARTMENT OF MINES
OIL AND GAS DIVISION

Quadrangle BLACKSVILLE

Permit No. XXXXXX

WELL RECORD

Oil or Gas Well Gas
(KIND)

Company Hope Natural Gas Co.
 Address Clarksburg, W. Va.
 Farm Jos. L. Tennant Acres 0.75
 Location (waters) 740
 Well No. Paw Paw Elev. 1072'
 District Marion County Marion
 The surface of tract is owned in fee by _____
 Address _____
 Mineral rights are owned by _____
 Address _____
 Drilling commenced 4-27-05
 Drilling completed 6-20-05
 Date Shot 12-15-09 From 2838 To 2848
 With 15 qts.
 Open Flow Exhausted /10ths Water in _____ Inch
 _____ /10ths Merc. in _____ Inch
 Volume _____ Cu. Ft.
 Rock Pressure ???? lbs. _____ hrs.
 Oil None
 WELL ACIDIZED No
 WELL FRACTURED No

Casing and Tubing	Used in Drilling	Left in Well	Packers
Size			
16			Kind of Packer _____
13			
10			Size of _____
8 1/4	<u>1187</u>	<u>1187</u>	Depth set _____
6 5/8	<u>2690</u>	<u>2690</u>	
5 3/16			
3	<u>2905</u>	<u>2905</u>	Perf. top _____
2			Perf. bottom _____
Liners Used			Perf. top _____
			Perf. bottom _____

CASING CEMENTED _____ SIZE _____ No. Ft. _____ Date _____
No cementing done

COAL WAS ENCOUNTERED AT 430 FEET 120 est INCHES


FEET INCHES FEET INCHES

FEET INCHES FEET INCHES

RESULT AFTER TREATMENT _____
ROCK PRESSURE AFTER TREATMENT _____
Fresh Water None recorded Feet _____ Salt Water _____ Feet _____

Formation	Color	Hard or Soft	Top	Bottom	Oil, Gas or Water	Depth	Remarks
Pittsburgh Coal			<u>430</u>	<u>440 est.</u>			
Little Dunkard			<u>810</u>	<u>875</u>			
Big Dunkard			<u>945</u>	<u>1040</u>			
Gas sand			<u>1165</u>	<u>1208</u>			
Salt Sand			<u>1375</u>	<u>1460</u>			
Pencil Cave			<u>1635</u>	<u>1670</u>			
Big Lime			<u>1670</u>	<u>1745</u>			
Big Injun			<u>1745</u>	<u>1885</u>			
Squaw			<u>1890</u>	<u>1920</u>			
Gantz			<u>2305</u>	<u>2325</u>			
50 foot			<u>2360</u>	<u>2410</u>			
4th Sand			<u>2668</u>	<u>2700</u>			
5th Sand			<u>2838</u>	<u>2840'</u>	<u>Gas</u>	<u>2838</u>	

TR - 2905 (bottom)

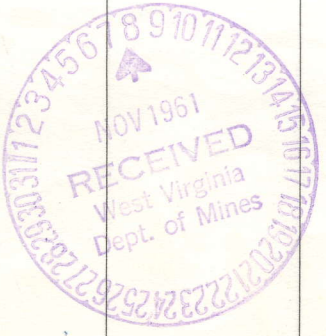

November 7, 1961
Jack Bailey
H. N. G. Co.

APR 6 1962

30907

STATE OF WEST VIRGINIA
DEPARTMENT OF MINES
OIL AND GAS DIVISION

AFFIDAVIT OF PLUGGING AND FILLING WELL

AFFIDAVIT SHOULD BE MADE IN TRIPPLICATE. ONE COPY MAILED TO THE DEPARTMENT ONE COPY TO BE RETAINED BY THE WELL OPERATOR AND THE THIRD COPY (AND EXTRA COPIES IF REQUIRED) SHOULD BE MAILED TO EACH COAL OPERATOR AT THEIR RESPECTIVE ADDRESSES.

<u>Eastern Gas & Fuel Associates</u> COAL OPERATOR OR OWNER <u>Grantown, W. Va.</u> ADDRESS	<u>Hope Natural Gas Company</u> NAME OF WELL OPERATOR <u>445 West Main Street, Clarksburg, W. Va.</u> COMPLETE ADDRESS
<u>Same</u> COAL OPERATOR OR OWNER	<u>19</u> WELL AND LOCATION
<u>Guy Ammons</u> LEASE OR PROPERTY OWNER <u>Fairview, W. Va.</u> ADDRESS	<u>Few Paw</u> District
	<u>Marion</u> County
	Well No. <u>740</u>
	<u>Jos. L. Tennant</u> Farm

STATE INSPECTOR SUPERVISING PLUGGING

AFFIDAVIT

STATE OF WEST VIRGINIA,

County of Marion

ss:

Carl T. Smith and William L. Moore
being first duly sworn according to law depose and say that they are experienced in the work of plugging and filling oil and gas wells and were employed by Hope Natural Gas Company, well operator, and participated in the work of plugging and filling the above well, that said work was commenced on the 21st day of November, 19 61, and that the well was plugged and filled in the following manner:

BAND OR ZONE RECORD	FILLING MATERIAL			PLUGS USED	CASING	
	FORMATION	CONTENT	FROM TO		SIZE & KIND	CSB PULLED
Native Coal	340	Aquagel	2905 2695			
Pgh. Coal	430	Cement	2695 2671		none	1487'
Little Dunkard	945-1040	Aquagel	2671 2285			
Gas Sand	1165-1208	Cement	2285 2261		5-1/2"	
2nd. Salt	1375-1460	Aquagel	2261- 1750		1755'	935'
Pencil Cove	1635-1670	Cement	1750 1725			
Big Lime	1670-1745	Aquagel	1725 1497		2-3/8"	
Big Injun	1745-1885	Cement	1497 1472		2696'	209'
Gantz	2305-2325	Aquagel	1472 1145			490**
Thirty Foot	2360-2410	Cement	1145 1120			
Fourth Sand	2668-2700	Aquagel	1120 790		**490'	2-3/8" Vent
Fifth Sand	2838-2846	Cement	790 765		installed thru coal	
Total Depth	2905	Aquagel	765 520			
		Open	520 490			
		Open (vented)	490 Surface	**		
		filled around vent as follows				
COAL BEAMS		Red Mud	490 485			
(NAME)		Limestone	485 475		DESCRIPTION OF MONUMENT	
(NAME)		Red Mud	475 470		Monument erected marked HNGCC	
(NAME)		Cement	470 420		Well #740	
(NAME)		Aquagel	420 375			
(NAME)		Cement	375 20			
(NAME)		Mud & Stone	20 Surface			